


Ellsworth
17 9W

Map No. **KANSAS** Sec. *14* Twp. *17* R. *9W*

Well No. *7 Mahoney* Farm
Bradley Oil Company

NORTH

15

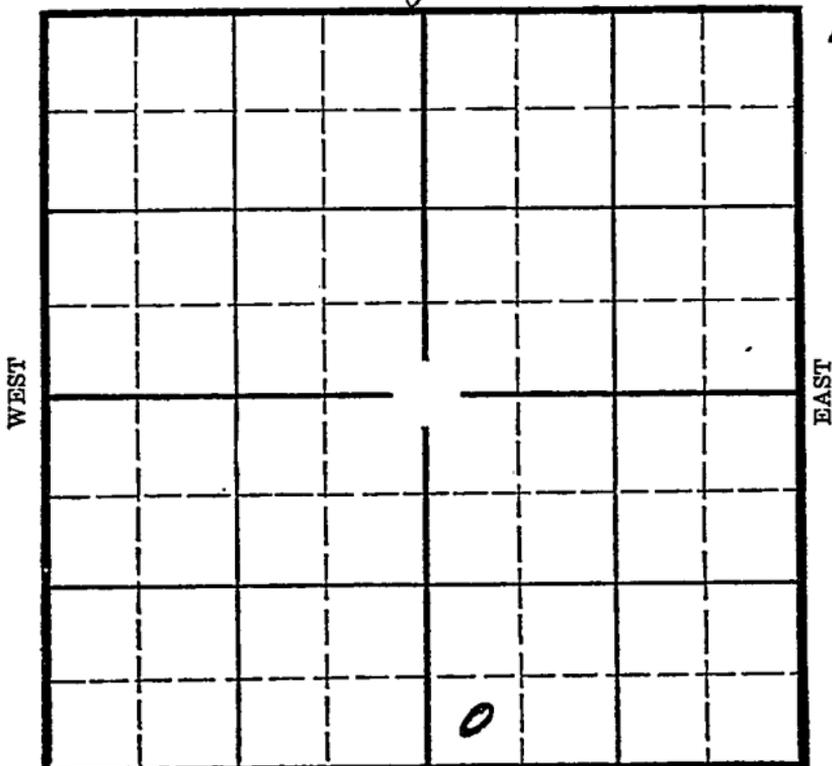

Location _____

Drilling Remarks _____

Rig Up _____

Drilling Remarks _____

RECORD

Cased _____ in. _____ ft.

Sand _____

Gas _____

Oil _____

Total Depth _____

PRODUCTION

1st 24 hrs. Nat. _____

1st 24 hrs. after shot _____

Gas _____ cu. ft. _____

Dry Hole _____

Abandoned _____

Ellsworth

Map No. KANSAS Sec. 14 Twp. 17 R. 9W


Well No. 7-Mahoney Farm
Bradley Oil Company

_____ Ft. from N. Line

330 Ft. from S. Line

_____ Ft. from E. Line

330 Ft. from W. Line

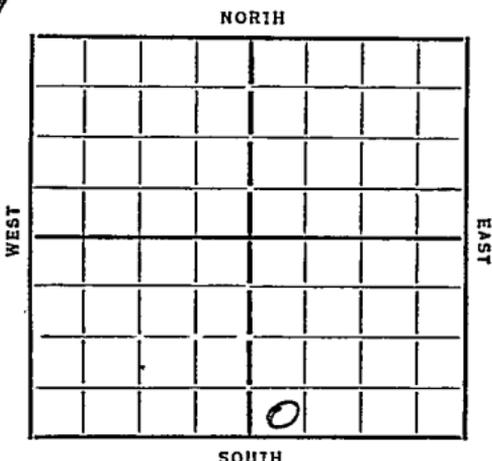

Date 1935

REPORT

1778

7/31 location
8/18 8/15 - 8/22
8/29 BR
9/6 Rgn
10/2 Del 3175
TD 3180
1470 Bbl.

COMPLETED

Edenworth
 Map No. 45 Sec. 14 Twp. 17 R. 9W
 Well No. 7-Mahoney
Bradley oil Company
 Contractor

FIRST REPORTS

SECTION PLAT

		0	

..... Ft. from N. Line

330 Ft. from S. Line

..... Ft. from E. Line

330 Ft. from W. Line

Location

Rig up.....

Drilling and Remarks:

RECORD

Cased..... in., ft.

Sand.....

Gas.....

Oil.....

Total Depth.....

PRODUCTION

1st 24 hrs. Nat.....

1st 24 hrs. after shot.....

Gas..... Cu. Ft.

Dry Hole.....

Abandoned.....

Date

7-31-35 192

ORVAL MANNSCHEIDT

Scout

KANSAS

Map No. 45 Sec. 14 Twp. 17 R. 9W

Well No. 7-Mahoney

Bradley Oil Company

Contractor

COMPLETED

SECTION PLAT

Ft. from N. Line

330 Ft. from S. Line

Ft. from E. Line

330 Ft. from W. Line

Location

Rig up

Drilling and Remarks:

1470 lbs

RECORD

Cased _____ in. _____ ft.

Sand oil 3175

Gas _____

Oil _____

Total Depth 3180

PRODUCTION

1st 24 hrs. Nat. _____

1st 24 hrs. after shot _____

Gas _____ Cu. Ft.

Dry Hole _____

Abandoned _____

Date

10-2-35 192

ORVAL MANNSCHRECK

Scout