


Section 14 Township 17 Range 9W

Well No. #1. Rodolph

Company Heathman Drlg.

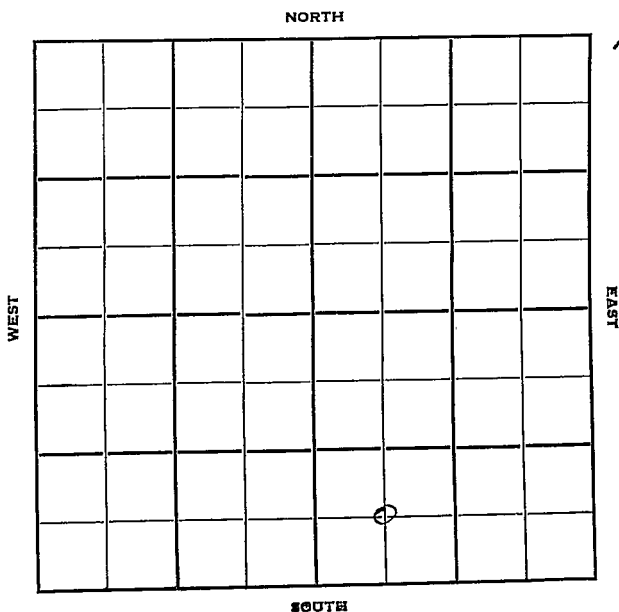

Sec. 14 Twp. 17 R. 9W

Well No. #1 Rodolph Farm

Heathman Drlg. Company

B & B Drlg. Contractor

Lorraine

 Ft. from N. Line


660'

 Ft. from S. Line

 Ft. from E. Line

660' Ft. from W. Line

C SW SE

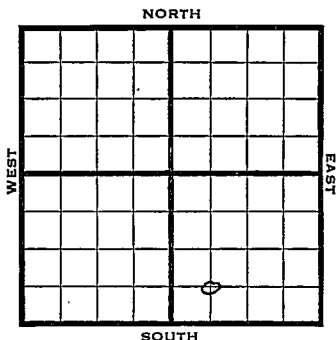

1950 Elev 1780' REPORT

2/15 Spud 2-12-50
8-5/8" @ 213'
Drlg. 1150'

5/3 TD 3196'
8 5/8" set 213'
Lans 2857'
Simp 3173'
Arb. 3183'
5" @ 3183'
D&A
Aband.

ABANDONED

Kansas


Map No. _____ Sec. 14 Twp. 17 R. 9WWell No. 1 Rodolph

Heathman Drlg. _____ Company

B & B Drlg. _____ Contractor

C SW SE

SECTION PLAT

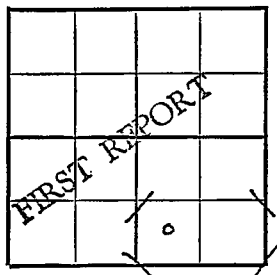

_____ Ft. from N. Line

660 Ft. from S. Line

_____ Ft. from E. Line

660 Ft. from W. Line

Ellsworth County

Location _____

Rig up _____

Drilling and Remarks:

Spud 2-12-50

8 5/8" @ 213

drlg. 1150

RECORD

Cased _____ in., _____ ft.

Sand _____

Gas _____

Oil _____

Total Depth _____

PRODUCTION

1st 24 hrs. Nat. _____

1st 24 hrs. after shot _____

Gas _____ Cu. Ft.

Dry Hole _____

Abandoned _____

Date

FEB 15 1950₁₉J. E. TYRA

Scout

Map No. _____ Sec. 14 Twp. 17 R. 9W

Well No. 1 Rodolph

Heathman Drlg. Company

Contractor

C SW SE


EI. 1780
SECTION PLAT

_____ Ft. from N. Line

660 Ft. from S. Line

_____ Ft. from E. Line

660 Ft. from W. Line

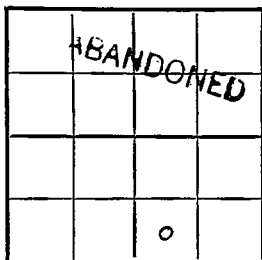

Ellsworth County

Location _____

Rig up _____

Drilling and Remarks:

8 5/8" @ 213
 Lens 2857
 Simp 3173
 Arb 3183
 5" @ 3183
 D+A

RECORD

Cased _____ in., _____ ft.

Sand _____

Gas _____

Oil _____

Total Depth 3196

PRODUCTION

1st 24 hrs. Nat. _____

1st 24 hrs. after shot _____

Gas _____ Cu. Ft.

Dry Hole _____

Abandoned _____

Date

MAY 3 1950

19

J. E. TYRA

Scout