


Ellsworth

Map No. KANSAS Sec. 14 Twp. 17 R. 9^w

Well No. #1 Rolf Farm _____
Empire Oil Company

_____ Ft. from N. Line
330 Ft. from S. Line
330 Ft. from E. Line
_____ Ft. from W. Line

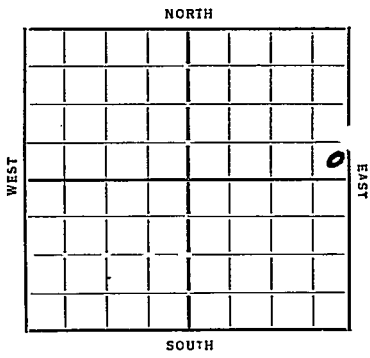

Date

REPORT

1935
2/20 Location
2/28 _____
3/7 Bldg.
3/14 Rig
3/21 150 247 WOC
3/28 Bldg 1800
4/4 " 2935
4/11 6" 3185 Rust
4/18 _____
4/26 Sil 3189 T 7 3195 H.F.O.
5/2 Pump 508 Bbls 8 hrs
5/8 Silicious 3189
T 7 3195
1451 Bbls.

COMPLETED


Map No. 45 Sec. 14 Twp. 17 R. 9W

Well No. 1- Rolf

Empire oil Company

Contractor

FIRST REPORT

SECTION PLAT

..... Ft. from N. Line

330 Ft. from S. Line

330 Ft. from E. Line

..... Ft. from W. Line

			0

Location.....

Rig up.....

Drilling and Remarks:

RECORD

Cased..... in., ft.

Sand.....

Gas.....

Oil.....

Total Depth.....

PRODUCTION

1st 24 hrs. Nat.....

1st 24 hrs. after shot.....

Gas..... Cu. Ft.

Dry Hole.....

Abandoned.....

Date

2-20-35 192.....

ORVAL MANNSCHRECK

Scout

Map No. 45 Sec. 14 Twp. 17 R. 9W

Well No. 1-Rolf
Empire oil Company

Contractor

COMPLETED

SECTION PLAT

Ft. from N. Line

330 Ft. from S. Line

330 Ft. from E. Line

Ft. from W. Line

			0

Location

Rig up

Drilling and Remarks:

1451 ft

RECORD

Cased in., ft.

Sand Silicious 3189

Gas

Oil

Total Depth 3195

PRODUCTION

1st 24 hrs. Nat.

1st 24 hrs. after shot

Gas Cu. Ft.

Dry Hole

Abandoned

Date

5-8-35 192

ORVAL MANSCHRECK

Scout