

Ellsworth

Map No.

ANSAS

Sec

14

Twp.

17

R.

9W

Well No.


6-Rolf

Farm

Empire Oil

Company

NORTH

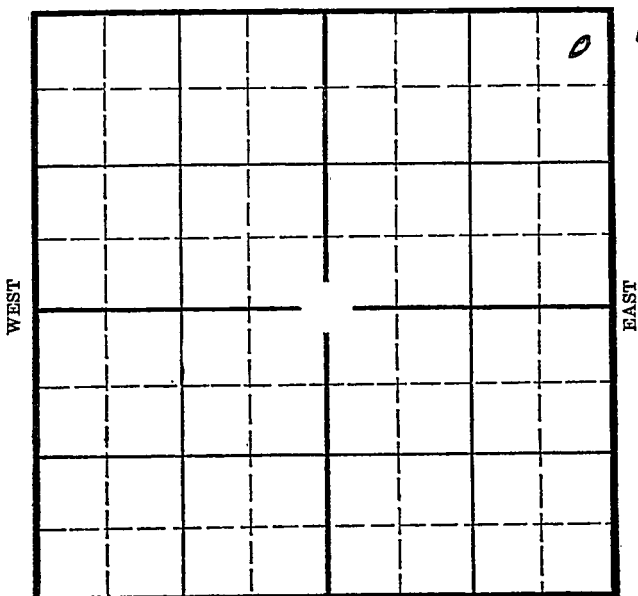

Location

Drilling Remarks

Rig Up

Drilling Remarks

RECORD

Cased \_\_\_\_\_ in. \_\_\_\_\_ ft.

Sand \_\_\_\_\_

Gas \_\_\_\_\_

Oil \_\_\_\_\_

Total Depth \_\_\_\_\_

PRODUCTION

1st 24 hrs. Nat. \_\_\_\_\_

1st 24 hrs. after shot \_\_\_\_\_

Gas \_\_\_\_\_ cu. ft. \_\_\_\_\_

Dry Hole \_\_\_\_\_

Abandoned \_\_\_\_\_



*Elkhorn*

Map No. *45* Sec. *14* Twp. *17* R. *9W*

Well No. *6-Rolf*

*Empire oil* Company

Contractor

SECTION PLAT

**FIRST REPORTS**  
*330* Ft. from N. Line

Ft. from S. Line

*330* Ft. from E. Line

Ft. from W. Line

			<i>0</i>

Location

Rig up

Drilling and Remarks:

*Good*

RECORD

Cased *1* in., *10* ft.

Sand

Gas

Oil

Total Depth

PRODUCTION

1st 24 hrs. Nat.

1st 24 hrs. after shot

Gas *10* Cu. Ft.

Dry Hole

Abandoned

Date

*6-5-35*

192

**MANNSCHRECK**

Scout

Map No. 45 Sec. 14 Twp. 17 R. 9W

Well No. 6 POLY

Empire Oil Company

Contractor

SECTION PLAT

~~CONTAINED~~

330 Ft. from N. Line

..... Ft. from S. Line

330 Ft. from E. Line

..... Ft. from W. Line

			0

Location.....

Rig up.....

Drilling and Remarks:

Sic 8209

Pump 1843  
oil 167 water

RECORD

Cased..... in., ..... ft.

Sand.....

Gas.....

Oil.....

Total Depth 3212

PRODUCTION

1st 24 hrs. Nat.....

1st 24 hrs. after shot.....

Gas..... Cu. Ft.

Dry Hole.....

Abandoned.....

Date

**ORVAL MANSCHRECK**

7/24/35 192.....

Scout