

Ellsworth

Map No. KANSAS Sec. 14 Twp. 17 R. 9W

Well No. 9- Rolf Farm


~~Empire Oil~~
Company
Cities-Service Oil

_____ Ft. from N. Line

330 Ft. from S. Line

_____ Ft. from E. Line

330 Ft. from W. Line

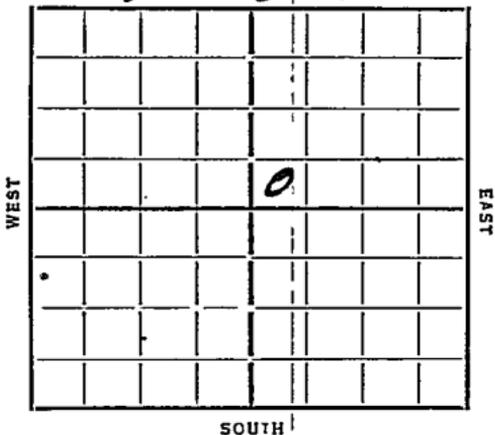

Date	REPORT	O. W. F. B.
7/24	Rog	
8/8	Dlf 800	15" 209
8/15	" 2741	
8/22	8" 3161 T 3165	
8/29	Sil 3184	3187 T 3189
	HFO 500 acid	
9/4	Sil 3184	
	T 3189	
	500 acid	
	287 Hole.	
	COMPLETED	
	OVER	

1939

O. W. P. B.

1/11

No Lans. Top available.

Arb. 3184-87' T.D.

Old Potential 2271 bbls.

Went to water.

P. B. 3118'.

Perf. 100 shots 3010-49;

Pay 3003-37'.

3000 acid.

Pumped 33 oil in 24 hours.

Minimum well.

FIRST REPORT

and

COMPLETED

Map No. 45 Sec. 14 Twp. 17 R. 9W

Well No. 9 Rod.

Empire Oil Company

Contractor

FIRST REPORTS

..... Ft. from N. Line

330 Ft. from S. Line

..... Ft. from E. Line

330 Ft. from W. Line

SECTION PLAT

		0	

Location.....

Rig up.....

Drilling and Remarks:

ROG

RECORD

Cased.....in.,ft.

Sand.....

Gas.....

Oil.....

Total Depth.....

PRODUCTION

1st 24 hrs. Nat.....

1st 24 hrs. after shot.....

Gas.....Cu. Ft.

Dry Hole.....

Abandoned.....

Date

7/27/35 192.....

FRANK MANSCHRECK Scout

no

Returned	
Cards	<i>CAH</i>
Tracing	<i>JTD</i>
Franco Man	<i>X</i>
Scarborough	<i>X</i>
Moody Man	<i>X</i>
Scarborough	
Moody Flat	

Edwards

1015

Form 26 - 1st Ed. 9-23
Map No. 46 Sec. 14 Twp. 17 R. 9W

Well No. 9. Rolf
Empire oil Company

~~CONTRACTOR~~
Contractor

SECTION PLAT

..... Ft. from N. Line
330 Ft. from S. Line
..... Ft. from E. Line
330 Ft. from W. Line

Location.....

Rig up.....

Drilling and Remarks:

500 and

287 lbs

RECORD

Cased..... in..... ft.

Sand..... 3184

Gas.....

Oil.....

Total Depth..... 3189

PRODUCTION

1st 24 hrs. Nat.....

1st 24 hrs. after shot.....

Gas..... Cu. Ft.

Dry Hole.....

Abandoned.....

Date

9-4-35 192

ORVAL MANNSCHRECK

Scout

Handwritten scribbles and lines, possibly initials or a signature, located in the upper right quadrant of the page.

Returned
Cards
Tracing
France Map
Scarborough Map
Moody Map
Scarborough Flat Book
Moody Flat Book

Map No. 45 Sec. 14 Twp. 17 R. 9W

Well No. 9 Rolfs

Cities Service Oil Company

FIRST REPORT Contractor

COMPLETED

SECTION PLAT

SW NE

		0	

_____ Ft. from N. Line

330 Ft. from S. Line

_____ Ft. from E. Line

330 Ft. from W. Line

EDWARDS POOL

Location _____

RECORD

Cased _____ in., _____ ft.

Sand _____

Gas _____

Oil _____

Total Depth _____

Drilling and Remarks:

OWPB (No Lens. Top Available)

Arb. 3184-87 TD

Old Poten. 2271

went to water

P.B. 3118

Perf. 100 shots

3010-49; Pay 3003

3000 acid

Pumped 33 oil in

24 hours

Date MIN. well

PRODUCTION

1st 24 hrs. Nat. _____

1st 24 hrs. after shot _____

Gas _____ Cu. Ft.

Dry Hole _____

Abandoned _____

JAN 11 1938

19

H. D. Hatfield

Scout

Misc. Small Maps
Cards
Tracing
France Map
Scarborough Map
Moody Map
Geological Dept.
Moody Flat Book

Edw
Cart
Map
RAH