

Map No. 1

Sec.

Two.

R.

Well No.

Farm

Company

NORTH

TELSELA

FAST

SOUTH

Location

Drilling Remarks

Rig Up

Drilling Remarks

RECORD

Cased_____in._____ft.

Sand-----

Gas _____

Oil_____

Total Depth_____

PRODUCTION

1st 24 hrs. Nat. _____

1st 24 hrs. after shot-----

Gas _____cu. ft._____


Dry Hole_____

Abandoned_____

Ellsworth

Map No. KANSAS Sec. 14 Twp. 17 R. 9W
Well No. 2- Rolfs Farm _____
Empire Oil Company _____

_____ Ft. from N. Line
330 Ft. from S. Line
990 Ft. from E. Line
_____ Ft. from W. Line

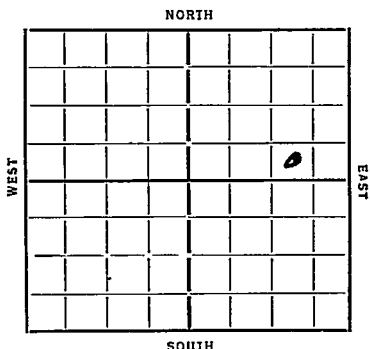

Date	REPORT
1935	
4/3	Bldg Rot Rig
4/11	Moving
4/18	12" 246 WOC
4/26	Blg 2100
5/2	2986
5/9	Simpson 3171 6" 3174
	T7 3175 Rust
5/15	Sil 3182 T7 3187
	1398 Bbls.

COMPLETED

Bellevue . KANSAS

Map No. 45 Sec. 14 Twp. 17 R. 9W

Well No. 2 - Rolfs

Empire Oil Company

Contractor

FIRST REPORTS

Ft. from N. Line

330 Ft. from S. Line

990 Ft. from E. Line

Ft. from W. Line

SECTION PLAT

			0

Location

Rig up

Drilling and Remarks:

Beag Rot. Rig

RECORD

Cased in., ft.

Sand

Gas

Oil

Total Depth

PRODUCTION

1st 24 hrs. Nat.

1st 24 hrs. after shot

Gas Cu. Ft.

Dry Hole

Abandoned

Date

4-3-35

192

ORVAL MANNSCHRECK

Scout

A handwritten signature in cursive script, appearing to read "J. C. C. C.", written in dark ink on a light background. The signature is slanted upwards from left to right. There are some small, dark, irregular marks above the signature, possibly ink splatters or additional markings.

1. *Map*
 2. *Map*
 263.

Edwards
 Map No. 45 Sec. 14 Twp. 17 R. 9W
 Well No. 2-Rolfs
Empire oil Company

Contractor

COMPLETED

SECTION PLAT

			0

Ft. from N. Line

330 Ft. from S. Line990 Ft. from E. Line

Ft. from W. Line

Location

Rig up

Drilling and Remarks:

1398 hbl

RECORD

Cased _____ in. _____ ft.

Sand 3182

Gas _____

Oil _____

Total Depth 3187

PRODUCTION

1st 24 hrs. Nat. _____

1st 24 hrs. after shot _____

Gas _____ Cu. Ft.

Dry Hole _____

Abandoned _____

Date

5-15-35 192 **ORVAL MANNSCHRECK** Scout

Returned

Cards

Tracing

France Map

Scarborough Map

Moody Map

Scarborough Plat Book

Moody Plat Book