


Form 51-5M-5-34-Palace

Map No. **KANSAS** Sec. **14** Twp. **11** R. **7**

Well No. 1-1015 Farm 1015

Company

NORTH

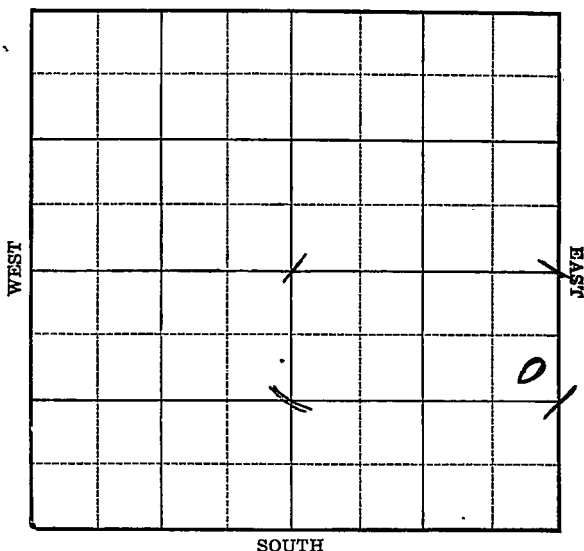

Location_____

Drilling Remarks

Rig Up_____

Drilling Remarks

RECORD

Cased_____in._____ft.

Sand_____

Gas _____

Oil_____

Total Depth_____

PRODUCTION

1st 24 hrs. Nat.-----

1st 24 hrs. after shot-----

Gas _____ cu. ft. _____

Dry Hole_____

Abandoned_____

Ellsworth


Map No. KANSAS Sec. 14 Twp. 17 R. 9 W
Well No. 1 Rolfs Farm
Atlantic Oil Company

990 Ft. from N. Line

 Ft. from S. Line

330 Ft. from E. Line

 Ft. from W. Line

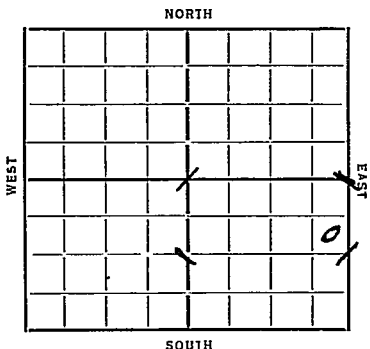

Date	REPORT
11/27	Location
12/6	Rig
12/13	Log 1180 12" 211
12/21	" 2205
12/27	" 3130 Launching 2867
1/3/35	Silicious 3193 7" 3193
	T 7 3198
1/9	Silicious 3193 T 7 3198
	687 Bbls.

COMPLETED

Zelmerworth

Map No. 45 Sec. 14 Twp. 17 R. 9WWell No. 1-RolfsAtlantic Oil Company

Contractor

FIRST REPORTS

SECTION PLAT

790 Ft. from N. Line

Ft. from S. Line

330 Ft. from E. Line

Ft. from W. Line

Location ✓

Rig up

Drilling and Remarks:

RECORD

Cased.....in.,ft.

Sand.....

Gas.....

Oil.....

Total Depth.....

PRODUCTION

1st 24 hrs. Nat.,.....

1st 24 hrs. after shot.....

Gas.....Cu. Ft.

Dry Hole.....

Abandoned.....

Date

ORVAL MANNSCHRECK

11-27-34 192.....Scout

Journal
no trace

Returned	PPH
Cards	
Tracing	WWS
France Map	
Scarbrough Map	
McL. Map	
Scarbrough Flat Book	
McL. Flat Book	

Map No. 45 Sec. 14 Twp. 17 R. 9WWell No. 1 - RolfsAtlantic Oil Company

Contractor

COMPLETED

SECTION PLAT

790 Ft. from N. Line

Ft. from S. Line

330 Ft. from E. Line

Ft. from W. Line

			0

Location

Rig up

Drilling and Remarks:

682 Rhs

RECORD

Cased in., ft.Sand siliceous 3193

Gas

Oil

Total Depth 3198

PRODUCTION

1st 24 hrs. Nat.

1st 24 hrs. after shot

Gas Cu. Ft.

Dry Hole

Abandoned

Date

ORVAL MANNSCHRECK

1-9-35 192 Scout

[illegible]