


Ellsworth

Form 51-5M-5-34-Palace

Map No. **KANSAS** Sec. 14 Twp. 17 R. 9W

Well No. 3 Rolfe Farm  
Atlantic Oil Prod. Company

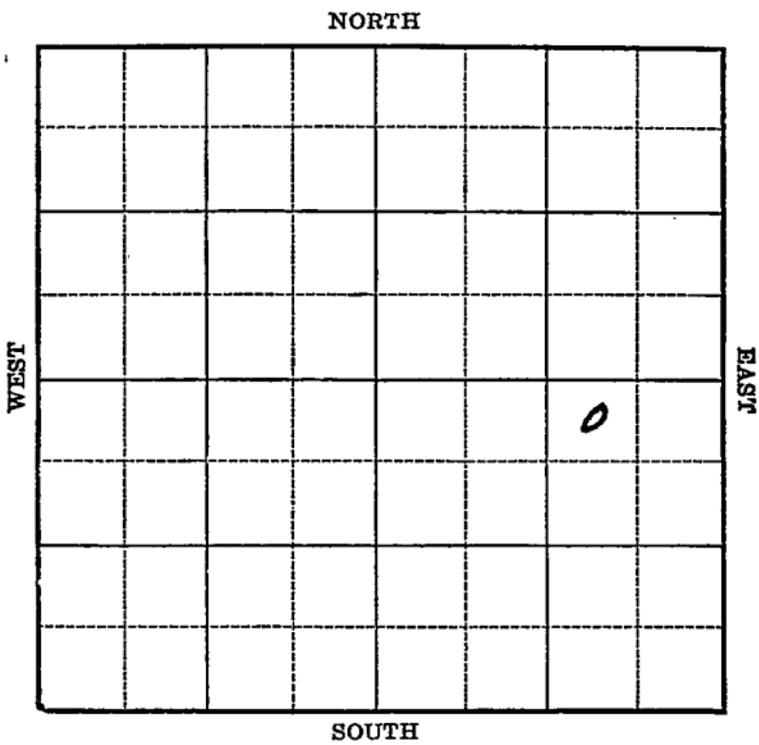

Location \_\_\_\_\_

Drilling Remarks \_\_\_\_\_

\_\_\_\_\_

\_\_\_\_\_

**RECORD**

Cased \_\_\_\_\_ in. \_\_\_\_\_ ft.

Sand \_\_\_\_\_

Gas \_\_\_\_\_

Oil \_\_\_\_\_

Total Depth \_\_\_\_\_

Rig Up \_\_\_\_\_

Drilling Remarks \_\_\_\_\_

\_\_\_\_\_

\_\_\_\_\_

**PRODUCTION**

1st 24 hrs. Nat. \_\_\_\_\_

1st 24 hrs. after shot \_\_\_\_\_

Gas \_\_\_\_\_ cu. ft. \_\_\_\_\_

Dry Hole \_\_\_\_\_

Abandoned \_\_\_\_\_



**KANSAS**

Map No. 45 Sec. 14 Twp. 17 R. 9W

Well No. 3 - Rolfs

Atlantic oil prod Company

Contractor

**FIRST REPORTS**

**SECTION PLAT**

330 Ft. from N. Line

..... Ft. from S. Line

990 Ft. from E. Line

..... Ft. from W. Line

			0

Location.....

Rig up.....

Drilling and Remarks:

*Rig*

**RECORD**

Cased..... in., ..... ft.

Sand.....

Gas.....

Oil.....

Total Depth.....

**PRODUCTION**

1st 24 hrs. Nat.....

1st 24 hrs. after shot.....

Gas..... Cu. Ft.

Dry Hole.....

Abandoned.....

Date

2-20-35 192

**ORVAL MANNSCHRECK**

Scout



Learned	<i>PH</i>
Fields	<i>PH</i>
Reading	<i>MWS</i>
Frame Map	<del>X</del>
Sea Brough Map	<del>X</del>
Moody Map	
Starbrough Plat Book	
Moody Plat Book	

Map No. 45 Sec. 14 Twp. 17 R. 9W

Well No. 3-Rolfs

Atlantic Oil prod Company

Contractor

**COMPLETED**

SECTION PLAT

330 Ft. from N. Line

..... Ft. from S. Line

990 Ft. from E. Line

..... Ft. from W. Line

			0

Location.....

Rig up.....

Drilling and Remarks:

765 ffb

RECORD

Cased..... in., ..... ft.

Sand Silicious 3193

Gas.....

Oil.....

Total Depth 3197

PRODUCTION

1st 24 hrs. Nat.....

1st 24 hrs. after shot.....

Gas..... Cu. Ft.

Dry Hole.....

Abandoned.....

Date

4-3-35 192.....

**ORVAL MANNSCHRECK**

Scout

Returned	<i>MS</i>
Cards	<i>MS</i>
Tracing	<i>MS</i>
France Map	<i>X</i>
Scarborough Map	<i>X</i>
Moody Map	<i>X</i>
See <i>MS</i> of Book	
Moody Flat Book	