

Ellsworth

Form 51-5M-5-34-Palace

Map No. KANSAS Sec. 14 Twp. 17 R. 9W

Well No. 3 Rolls Farm

Empire Oil Company

NORTH

WEST

EAST

SOUTH

Location

Drilling Remarks

Rig Up

Drilling Remarks

RECORD

Cased in. ft.

Sand

Gas

Oil

Total Depth

PRODUCTION

1st 24 hrs. Nat.

1st 24 hrs. after shot

Gas cu. ft.

Dry Hole

Abandoned

Ellsworth


Map No. **KANSAS** Sec. **14** Twp. **17** R. **9W**
Well No. **3- Rolfe** Farm
Empire Oil Company

_____ Ft. from N. Line

990 Ft. from S. Line

330 Ft. from E. Line

_____ Ft. from W. Line

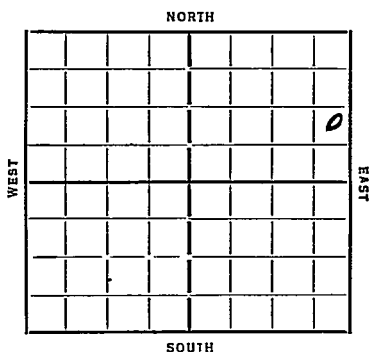

Date **1935**

REPORT

4/10 Location
4/18 Bldg
4/26 Rgn
5/2 Bldg 800 15" 227
5/9 " 2900
5/16 8" 3167 T 7 3171 Rust
5/23 Pump 3176 Bldg 3181
5/28 Sil 3186 T 7 3193
1336 Bldg

COMPLETED

Map No. 45 Sec. 14 Twp. 17 R. 9WWell No. 3- RolfsEmpire oil

Company

Contractor

FIRST REPORTS

SECTION PLAT

			o

Ft. from N. Line

990 Ft. from S. Line330 Ft. from E. Line

Ft. from W. Line

Location 

Rig up

Drilling and Remarks:

RECORD

Cased.....in.,ft.

Sand.....

Gas.....

Oil.....

Total Depth.....

PRODUCTION

1st 24 hrs. Nat.....

1st 24 hrs. after shot.....

Gas.....Cu. Ft.

Dry Hole.....

Abandoned.....

Date

ORVAL MANNSCHRECK

4-10-35 192.....Scout

no well

Returned	<i>AM</i>
Cards	<i>AM</i>
Tracing	<i>WBS</i>
France Map	X
Scarborough Map	X
Moody Map	X
Scarborough Plat Book	
Moody Plat Book	

Map No. K 45 Sec. 14 Twp. 17 R. 9WWell No. 3- RolfsEmpire oil Company

Contractor

COMPLETED

SECTION PLAT

			0

Ft. from N. Line

990 Ft. from S. Line330 Ft. from E. Line

Ft. from W. Line

Location

Rig up

Drilling and Remarks:

1336 lbs

RECORD

Cased _____ in. _____ ft.

Sand Sil 3186

Gas _____

Oil _____

Total Depth 3193

PRODUCTION

1st 24 hrs. Nat. _____

1st 24 hrs. after shot _____

Gas _____ Cu. Ft.

Dry Hole _____

Abandoned _____

Date

ORVAL MANNSCHRECK5-25-35 192 Scout

Returned

Cards

Tracing

France Map

Scarborough Map

Moody Map

Scarborough Plat Book

Moody Plat Book