


Atlantic Oil Prod. Company

NORTH

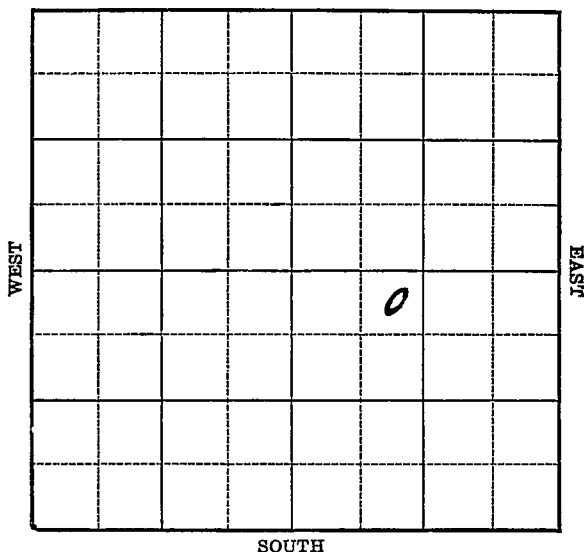

Location _____

Drilling Remarks

Rig Up_____

Drilling Remarks

RECORD

Cased _____ in. _____ ft.

Sand_____

Gas _____

Oil

Total Depth_____

PRODUCTION

1st 24 hrs. Nat. _____

1st 24 hrs. after shot_____

Gas _____ cu. ft. _____

Dry Hole

Abandoned_____

Ellsworth

Map No. KANSAS Sec. 14 Twp. 17 R. 9W


Well No. 5- Rolfe Farm
Atlantic Oil Prod. Company

330 Ft. from N. Line

_____ Ft. from S. Line

_____ Ft. from E. Line

990 Ft. from W. Line

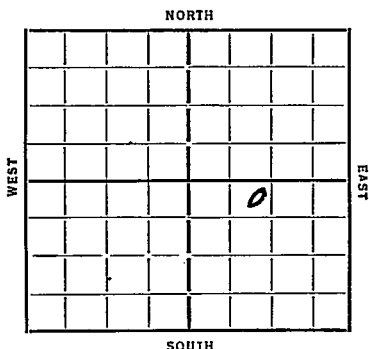

Date 1935

REPORT

4/10 MO R.
4/18 Rot. Rig
4/26 Rgn
5/2 dly 700 10" 206
5/9 " 2315
5/16 " 3070
5/23 Sil 3186 1/2 3189 1/2
 7" 3184
5/29 dly plugs
6/5 Silicouk 3186 1/2
 T 7 3189 1/2
 1069 Bbl.

COMPLETED

Map No. 45 Sec. 14 Twp. 17 R. 9W

Well No. 5 - Rolfs

Atlantic oil prod Company

Contractor

FIRST REPORTS

SECTION PLAT

330 Ft. from N. Line

.....Ft. from S. Line

.....Ft. from E. Line

990 Ft. from W. Line

		0	

Location.....

Rig up.....

Drilling and Remarks:

W.O.G.

RECORD

Cased.....in., ...ft.

Sand.....

Gas.....

Oil.....

Total Depth.....

PRODUCTION

1st 24 hrs. Nat.....

1st 24 hrs. after shot.....

Gas.....Cu. Ft.

Dry Hole.....

Abandoned.....

Date

ORVAL MANNSCHRECK

4-10-35 192.....Scout

Returned MA
Cards MA
Tracing MA
France Map X
Scarborough Map X
Moody Map X
Scarborough Flat Book
Moody Flat Book

Map No. 135 Sec. 14 Twp. 17 R. 9WWell No. 5-RolfsAtlantic Oil Company

Contractor

CORRECTION

SECTION PLAT

330 Ft. from N. Line

Ft. from S. Line

Ft. from E. Line

990 Ft. from W. Line

		0	

Location

Rig up

Drilling and Remarks:

1069
pplo

RECORD

Cased in, ft.

Sand 3186 1/2

Gas

Oil

Total Depth 3189 1/2

PRODUCTION

1st 24 hrs. Nat.

1st 24 hrs. after shot

Gas Cu. Ft.

Dry Hole

Abandoned

Date

6-5-35 192 Scout

Returned *CM*
 Cards *CM*
 Tracing *JP*
 France Map *X*
 Scarborough Map *X*
 Moody Map *X*
 Scarborough Plot Book
 Moody Plot Book