




Ellsworth

Map No. KANSAS Sec. 14 Twp. 17 R. 9 W

Well No. 6-Rolfs Farm  
Atlantic Oil Company

990 Ft. from N. Line  
Ft. from S. Line  
Ft. from E. Line  
990 Ft. from W. Line

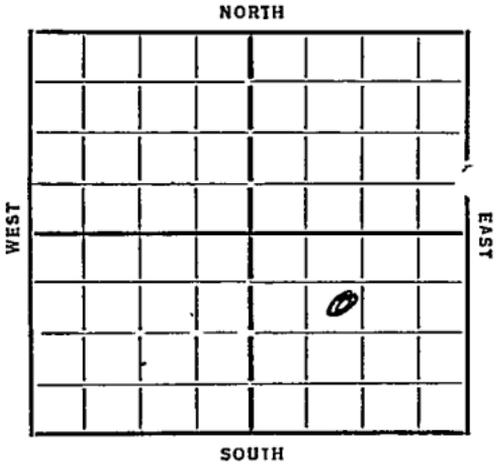

~~EIGHTH~~

Date: 1935

REPORT

5/8 Moving In  
5/16 Rot Rig  
5/23 —  
5/29 dly 300 10" 206  
6/6 " 2015  
6/13 " 3010 K @ 2860.  
6/20 7" 3186 Oil 3187-91  
6/28 Bailing  
6/28 195 Bbls 3 hrs.  
7/2 Oil 3187 T 7 3191  
7/2 1163 Bbls 18 hrs.

COMPLETED

*Edwards*

Map No. *45* Sec. *14* Twp. *17* R. *9W*

Well No. *6 - Rays*

*Atlantic Oil*

Company

Contractor

FIRST REPORTS


SECTION PLAT

*990* Ft. from N. Line

..... Ft. from S. Line

..... Ft. from E. Line

*990* Ft. from W. Line

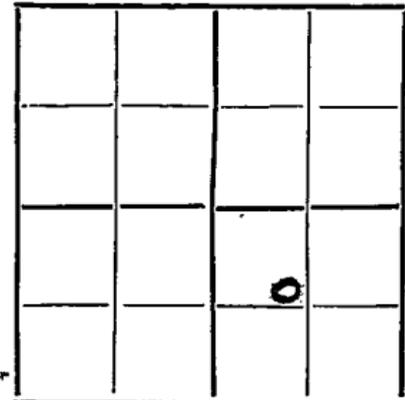

Location.....

Rig up.....

Drilling and Remarks:

*Moving in*

RECORD

Cased.....in., .....ft.

Sand.....

Gas.....

Oil.....

Total Depth.....

PRODUCTION

1st 24 hrs. Nat.....

1st 24 hrs. after shot.....

Gas.....Cu. Ft.

Dry Hole.....

Abandoned.....

Date

*5-8-35* 192.....

ORVAL MANNSCHRECK

Scout

*Handwritten scribbles and lines, possibly initials or a signature, located in the upper right quadrant of the page.*

Returned	
Cards	<i>CPA</i>
Tracing	<i>Maps</i>
France Map	X
Sea. borough Map	X
Moody Map	X
Sea. borough Post Book	
Moody Plat Book	

*Edwards*  
Map No. 45 Sec. 14 Twp. 17 R. 9W


Well No. 6 - Rolfs  
Atlantic Oil Company

Contractor

~~UNFILED~~

SECTION PLAT

990 Ft. from N. Line  
..... Ft. from S. Line  
..... Ft. from E. Line  
990 Ft. from W. Line

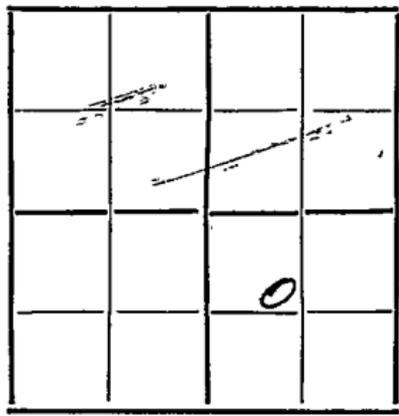

Location.....

Rig up.....

Drilling and Remarks:

*1163 lbs.  
18 hrs*

RECORD

Cased..... in., ..... ft.  
Sand oil 3187  
Gas.....  
Oil.....  
Total Depth 3191

PRODUCTION

1st 24 hrs. Nat.....  
1st 24 hrs. after shot.....  
Gas..... Cu. Ft.  
Dry Hole.....  
Abandoned.....

Date 7-2-35 192.....

~~OSVAL MANNSCHECK~~

Scout

*2 me waded*

Returned	
Cards	<i>CB</i>
Tracing	<i>JP</i>
France map	<i>✓</i>
Scarborough Map	<i>X</i>
Moody Map	<i>✓</i>
Scarborough Plat Book	<i>1</i>
Moody Plat Book	