


Ellsworth 14 17 90


Well No. 7-Rolls Farm Empire Oil Company

NORTH

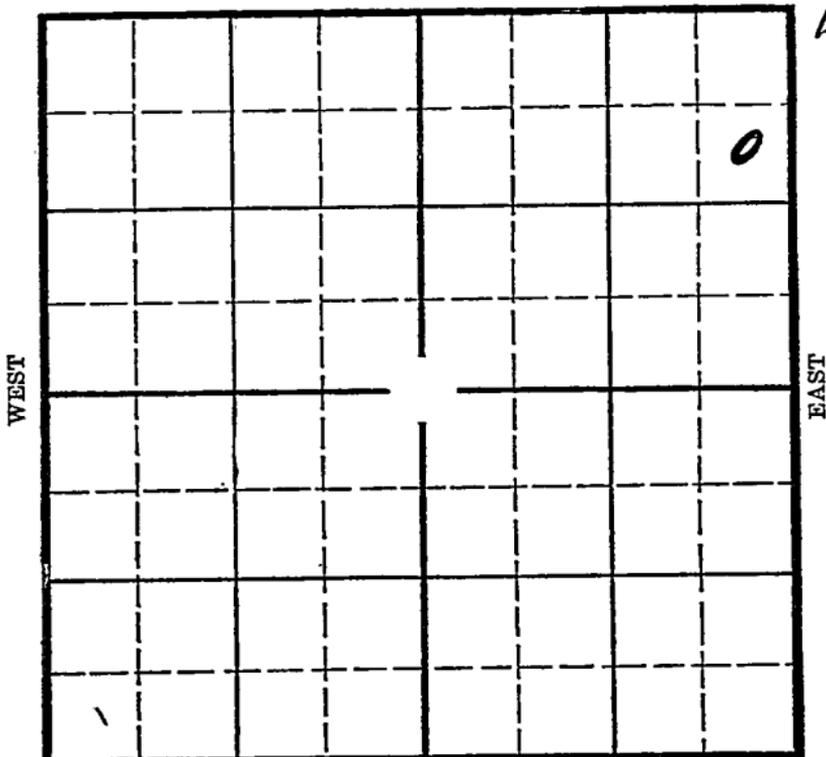

Location _____
Drilling Remarks _____

Rig Up _____
Drilling Remarks _____

RECORD

PRODUCTION

Cased _____ in. _____ ft.
Sand _____
Gas _____
Oil _____
Total Depth _____

1st 24 hrs. Nat. _____
1st 24 hrs. after shot _____
Gas _____ cu. ft. _____
Dry Hole _____
Abandoned _____

Ellsworth

KANSAS

Map No. _____ Sec. 14 Twp. 17 R. 9W

Well No. 7-Rolfs Farm _____
Empire Oil Company _____


990 Ft. from N. Line

_____ Ft. from S. Line

330 Ft. from E. Line

_____ Ft. from W. Line

Elev. 1789

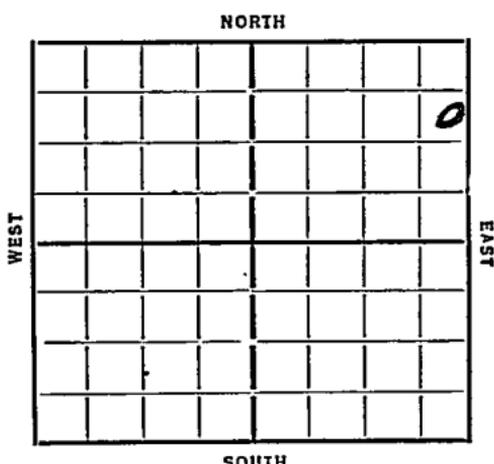

Date	REPORT
6/17	Location
6/20	Rgn
6/28	dy 1560 10" 210
7/3	" 7690 Lane 2880
7/11	8" 3169 T 7 3174 Rust
7/18	Simp 3160 Sil 3187
	3190 T 7 670 Bbls 8 hrs.
7/24	Sil 3187
	T 7 3190
	Pump 1884 Bbls

COMPLETED

Edsforth

Map No. *45* Sec. *14* Twp. *17* R. *9W*

Well No. *7 - Ropes*

Empire oil Company

Contractor

FIRST REPORTS

990 Ft. from N. Line

..... Ft. from S. Line

330 Ft. from E. Line

..... Ft. from W. Line

SECTION PLAT

			<i>0</i>

Location.....

Rig up.....

Drilling and Remarks:

RECORD

Cased..... in., ft.

Sand.....

Gas.....

Oil.....

Total Depth.....

PRODUCTION

1st 24 hrs. Nat.....

1st 24 hrs. after shot.....

Gas..... Cu. Ft.

Dry Hole.....

Abandoned.....

Date

6-17-35 192.....

W. J. MANNSCHECK

Scout

no wall map

Returned

Cards

Tracing





Wood's Book

KANSAS

Map No. 45 Sec. 14 Twp. 17 R. 9W

Well No. 7 R. H.

Empire Oil Company

Contractor



SECTION PLAT

990 Ft. from N. Line

..... Ft. from S. Line

330 Ft. from E. Line

..... Ft. from W. Line

			0

Location.....

Rig up.....

Drilling and Remarks:

Oil 3187

Pump 1884 oil

RECORD

Cased..... in., ft.

Sand.....

Gas.....

Oil.....

Total Depth 3190

PRODUCTION

1st 24 hrs. Nat.....

1st 24 hrs. after shot.....

Gas..... Cu. Ft.

Dry Hole.....

Abandoned.....

Date

7/24/35 192.....

ORVAL MANNSCHRECK

Scout

no wall

Return	<i>RAI</i>
Goods	
Trains	<i>RAI</i>
