


Map No. 8-14 Sec. 17 Twp. 9W
 Well No. Atlantic Prod Farm _____ Company _____

NORTH

10

WEST

EAST

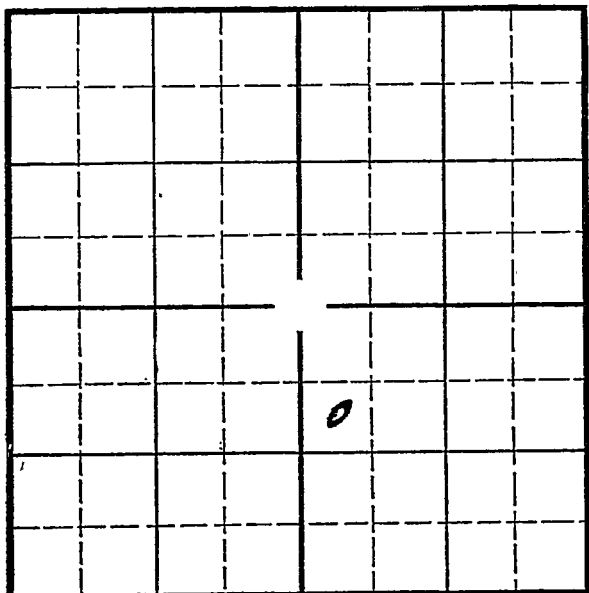

SOUTH

Location _____

Drilling Remarks _____

Rig Up _____

Drilling Remarks _____

RECORD

Cased _____ in. _____ ft.

Sand _____

Gas _____

Oil _____

Total Depth _____

PRODUCTION

1st 24 hrs. Nat. _____

1st 24 hrs. after shot _____

Gas _____ cu. ft. _____

Dry Hole _____

Abandoned _____

Ellsworth

Map No. KANSAS Sec. 14 Twp. 17 R. 9W


Well No. 8-Rolfs Farm
Atlantic Prod. Company

990 Ft. from N. Line

_____ Ft. from S. Line

_____ Ft. from E. Line

330 Ft. from W. Line

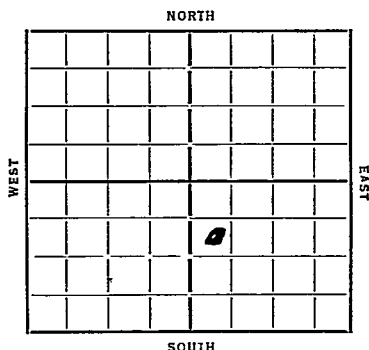

Elev. 1781

Date 7/3 REPORT

6/26 Cellar

7/3 Rig

7/11 _____

7/18 10" 300

8/8 Sil 3188 7" 3188

8/15 Set core 3193 Rust

8/22 1000 acid No Hdp.

8/29 Shot 30 gts 3189-931 C.O.

9/6 3202 T7 HFO.

9/20 Sil 3188

T7 3202

240 Hdp.

COMPLETED

Map No. 45 Sec. 14 Twp. 17 R. 9 WWell No. 8 RdsAtlantic Pivotal Company

Contractor

SECTION PLAT

		0	

290 Ft. from N. Line

Ft. from S. Line

Ft. from E. Line

330 Ft. from W. Line

FIRST REPORTS

Location

Rig up

Drilling and Remarks:

Cellar

RECORD

Cased _____ in., _____ ft.

Sand _____

Gas _____

Oil _____

Total Depth _____

PRODUCTION

1st 24 hrs. Nat. _____

1st 24 hrs. after shot _____


Gas _____ Cu. Ft.

Dry Hole _____

Abandoned _____

Date

67/26/25 192 ORVAL MANNSCHRECK Scout

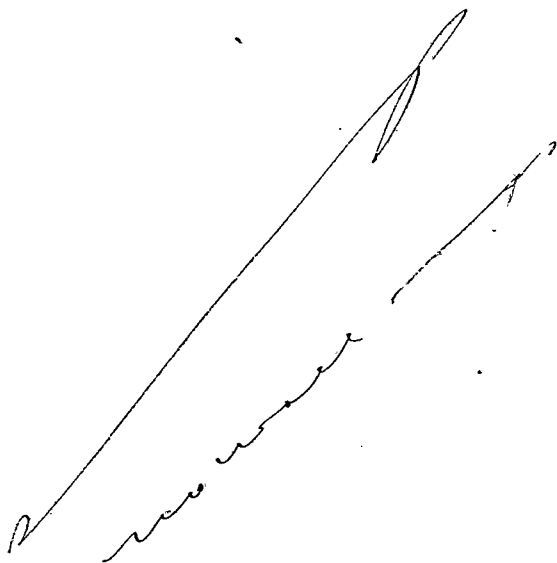


Ellsworth

Map No. *45* Sec. *14* Twp. *17* R. *9W*

Well No. *8-Ralphs*

Atlantic Prod Company

Contractor

KANSAS

SECTION PLAT

990 Ft. from N. Line

Ft. from S. Line

Ft. from E. Line

330 Ft. from W. Line

		0	

Location

Rig up

Drilling and Remarks:

240 lbs

RECORD

Cased in ft.

Sand *Sil 3378*

Gas *3188*

Oil

Total Depth *3207*

PRODUCTION

1st 24 hrs. Nat.

1st 24 hrs. after shot

Gas Cu. Ft.

Dry Hole

Abandoned

Date

9-20-35

ORVAL MANN SCHRECK

Scout

Handwritten scribbles at top of page

Returned	<i>AD</i>
Cards	
Tracing	<i>Done</i>
France Map	<i>X</i>
Scarborough Map	<i>X</i>
Moody Map	<i>X</i>
Scarborough Plat Book	
Moody Plat Book	

Handwritten scribbles at bottom of page