


NORTH

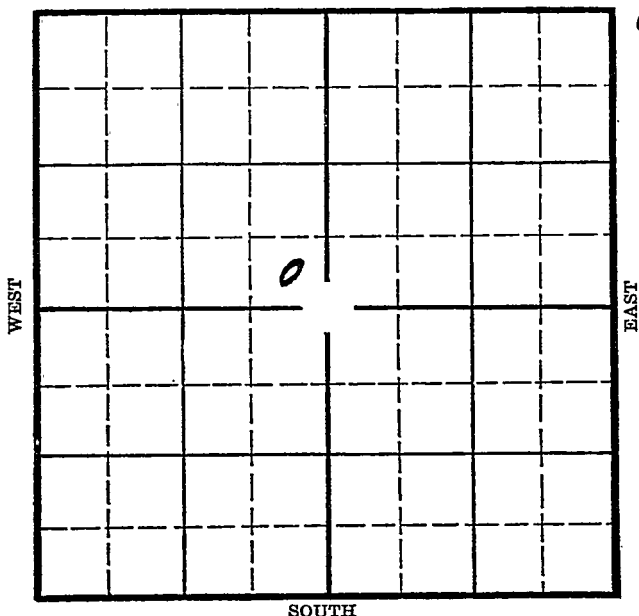

Rig Up_____

Drilling Remarks

PRODUCTION

1st 24 hrs. Nat. _____

1st 24 hrs. after shot_____

Gas_____cu. ft._____

Dry Hole_____

Abandoned_____

Ellsworth

Map No. KANSAS Sec. 14 Twp. 17 R. 9W
Well No. 1-B Schmidt Farm
Empire oil Company


_____ Ft. from N. Line

330 Ft. from S. Line

330 Ft. from E. Line

_____ Ft. from W. Line

Elev. 1789

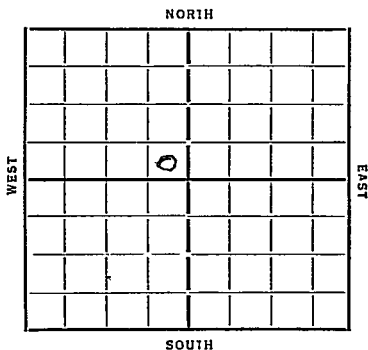

Date 1935

REPORT

8/17 cellar

8/15 Rgn

8/22 ally 655

8/29 " 2370

9/6 Cong 3169 7" 3180 Rnd

10/3 10/10

11/1 SP.

11/7 11/14

11/20 Cong 3169

TD 3214

D & A.

ABANDONED

Edsforth
Map No. 45 Sec. 14 Twp. 17 R. 9WWell No. 1B-1 SchmidtEmpire oil Company

Contractor

SECTION PLAT

	0		

Ft. from N. Line

330 Ft. from S. Line330 Ft. from E. Line

Ft. from W. Line

Location

Rig up

Drilling and Remarks:

cellar

RECORD

Cased.....in.,ft.

Sand.....

Gas.....

Oil.....

Total Depth.....

PRODUCTION

1st 24 hrs. Nat.....

1st 24 hrs. after shot.....

Gas.....Cu. Ft.

Dry Hole.....

Abandoned.....

Date

8-7-35 192 AL. MANISCHRECK Scout

KANSAS

Map No. 45 Sec. 14 Twp. 17 R. 9WWell No. 1B-SchmidtEmpire Oil

Company

Contractor

ABANDONED

SECTION PLAT

	0		

Ft. from N. Line

330 Ft. from S. Line330 Ft. from E. Line

Ft. from W. Line

Location

Rig up

Drilling and Remarks:

10 + 17

RECORD

Cased in. ft.

Sand Long. 3169

Gas

Oil

Total Depth 3214

PRODUCTION

1st 24 hrs. Nat.

1st 24 hrs. after shot

Gas Cu. Ft.

Dry Hole

Abandoned

Date

11-20-35 192 Scout

OIL & GAS