

Ellsworth

Map No. KANSAS Sec. 14 Twp. 17 R. 9W

Well No. 5- Rolfs Farm


Empire Oil Company
Cities-Service Oil NORTH

_____ Ft. from N. Line

990 Ft. from S. Line

990 Ft. from E. Line

_____ Ft. from W. Line

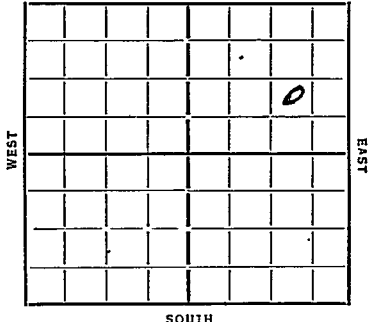

Elev. 1786

Date 1935 REPORT **O. W. P. B.**

5/15 Bldg

5/23 —

5/29 16" 222 woc

6/6 dly 1850

6/13 " 3154

6/20 Ail 3175-78 3100 oil 3 hrs

tubg

6/26 Ail 3175-78

T 7 3178

Pump 1750 Bldg

COMPLETED

OVER

O. W. P. B.

1939

1/11

Arb. 3175-78' T.D.

Old potential 1750'.

Went to water.

P. B. to 3102'.

No Lans. top available

Perf. 3025-49'.

Pay 3033-43'.

2000 acid.

Pump 25 oil 10 hrs.

Minimum well.

FIRST REPORT

and

COMPLETED

Ellsworth

Map No. 45 Sec. 14 Twp. 17 R. 9W

Well No. 5 - Ruffs

Empire oil Company

Contractor

FIRST REPORTS

SECTION PLAT

..... Ft. from N. Line

990 Ft. from S. Line

990 Ft. from E. Line

..... Ft. from W. Line

			0

Location.....

Rig up.....

Drilling and Remarks:

Bed

RECORD

Cased..... in., ft.

Sand.....

Gas.....

Oil.....

Total Depth.....

PRODUCTION

1st 24 hrs. Nat.....

1st 24 hrs. after shot.....

Gas..... Cu. Ft.

Dry Hole.....

Abandoned.....

Date

5-15-35 192

ORVAL MANNSCHRECK
Scout

no more

Returned
Cards
Tracing
France Map
Scarborough Map
Moody Map
Scarborough Plat Book
Moody Plat Book

Map No. 45 Sec. 14 Twp. 17 R. 9N

Well No. 5 Rolfe

Empire Oil Company

Contractor

SECTION PLAT

			0

..... Ft. from N. Line

990 Ft. from S. Line

990 Ft. from E. Line

..... Ft. from W. Line

COMPLETED

Location.....

Rig up.....

Drilling and Remarks:

Oil 3175-78

Pump 1750 ft

RECORD

Cased..... in., ft.

Sand.....

Gas.....

Oil.....

Total Depth... 3178

PRODUCTION

1st 24 hrs. Nat.....

1st 24 hrs. after shot.....

Gas..... Cu. Ft.

Dry Hole.....

Abandoned.....

Date

6/26/35 192

ORVAL MANNSCHRECK

Scout

no wall map

Returned	<i>Call</i>
Cards	<i>Call</i>
Tracing	<i>Call</i>
France Map	<i>X</i>
Scarborough Map	<i>X</i>
Muddy Map	<i>X</i>
Scarborough Plat Book	
Muddy Plat Book	

Ellsworth

Map No. 45 Sec. 14 Twp. 17 R. 9W

Well No. 5 Rolfs

Cities Service Oil Company

Contractor

COMPLETED

FIRST REPORT SECTION PLAT

NW SE NE

_____ Ft. from N. Line

990 Ft. from S. Line

990 Ft. from E. Line

_____ Ft. from W. Line

			0

EDWARDS POOL

Location _____

Rig up _____

Drilling and Remarks:

OWPB (No Logs Top Available)

Arb. 3175-78 TD.

Old. Poten. 1750

BB. 3102

Perf. 3025-49

Pay 3033-43

2000 Acid; Pump

25 oil -10 hrs.

Min. well

RECORD

Cased _____ in., _____ ft.

Sand _____

Gas _____

Oil _____

Total Depth _____

WENT TO WTR

PRODUCTION

1st 24 hrs. Nat. _____

1st 24 hrs. after shot _____

Gas _____ Cu. Ft.

Dry Hole _____

Abandoned _____

Date

JAN 11 1938

19

H. D. Hatfield

Scout

