


Section 14 Township 17 Range 9WWell No. #2 RowlandCompany Heathman Drlg.

NORTH

2

WEST

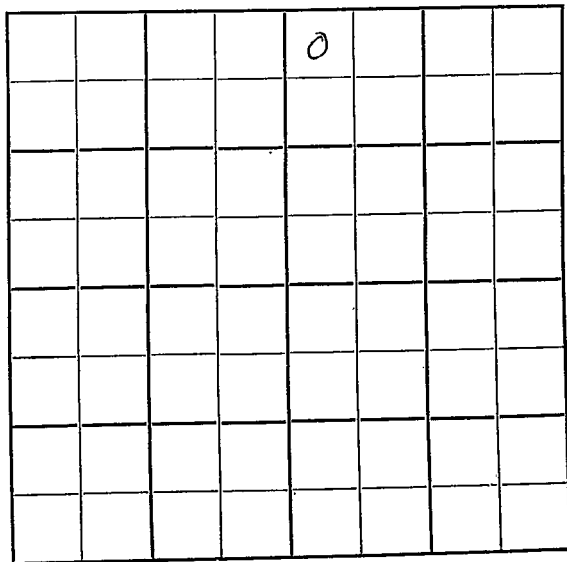

EAST

SOUTH

KANSAS

Ellsworth

Sec. 14 Twp. 17 R. 9-W ✓

Well No. #2 Rowland Farm

Heathman Drlg. Company

Heathman Drlg. - Contr. Contractor

Lorraine


330 Ft. from N. Line

 Ft. from S. Line

 Ft. from E. Line

330 Ft. from W. Line

NW NW NE

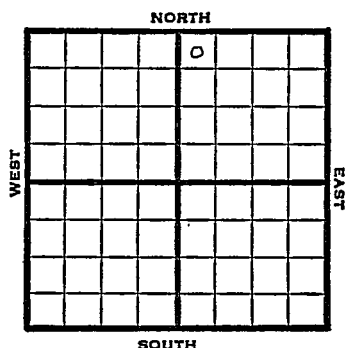

1950

Elev. 1801' REPORT

9/13

Spud 9-10-50

10" @ 208

Drlg 450

11/1

Spud 9-10-50

SWD Well TD 3915'

10" @ 208' Anhy 470'

Heeb 2766' Br Lime 2885'

KC 2906' Simp. 3317'

Arb. 3326'

6" @ 3376' TD 3915'

Comp. for SWD well

ABANDONED

County Ellsworth State KansasSec. 14 (Blk. Twp.) 17 (Sur. Rge.) 9W Map No.Operator Heathman Drlg.Well No. 2 Farm RowlandElev. Location NW NW NE

FIRST REPORT

330 Ft. From N Line NE330 Ft. From W Line Quarter1st. Report SEP 13 1950

Completion

Remarks

Spudding Date 9-10-50Drlg. Data Lorraine Pool10" @ 208 drlg. 450


J. E. TYRA

Orig. Data

SEP 15 1960

Scout Cards	7 w
Land Small Map	
Land Wall Map	3
Tracings	
France Map	
Pierce Map	
Misc.	

County Ellsworth State Kansas
 Sec. 14 (Blk. 17) (Sur. 9W) Map No.
 Operator Heathman Drlg.
 Well No. 2 Farm Rowland
 Elev. 1801 Location NW NW NE

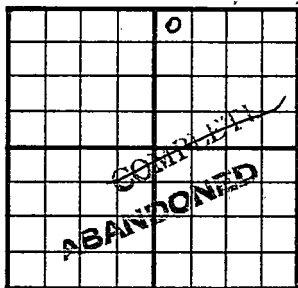

330 Ft. From N Line NE

330 Ft. From W Line Quarter

1st. Report

Completion NOV 1 1950

Remarks Lorraine Pool

Heathman Drlg. - Contr.

Spudding Date 9-10-50

Drlg. Data SWD well TD 3915

10" @ 208 Anhy 470 Heeb. 2766

Br. lime 2885 KC 2906 Simp. 3317

Arb. 3326 6" @ 3376 TD 3915

Comp. for SWD well

J. E. TYRA

Scout Cards	
Land Small Map	
Land Wall Map	
Tracing	
Flower Map	
Picture Map	
Misc.	

NOV 7