

KANSAS


FORM 51 5M 1-42 PETROL

Ellsworth

Section 14 Township 17 Range 10-W

Well No. #2 of Peterman

Company Vickers

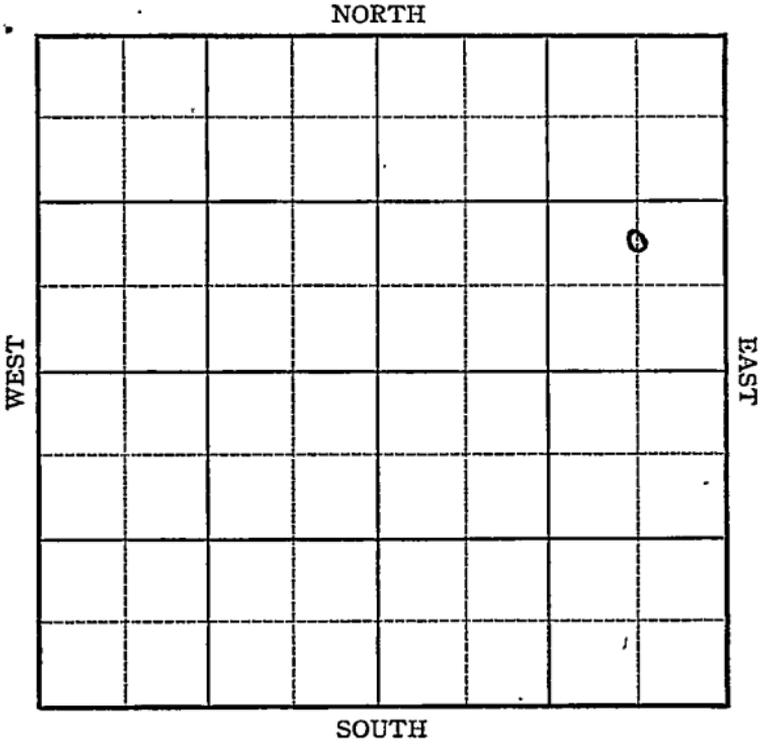

Sec. 14 Twp. 17 R. 10-W

Well No. #2 Peterman Farm

Vickers Company


Stoltenberg

 Ft. from N. Line

990 Ft. from S. Line

660 Ft. from E. Line

 Ft. from W. Line

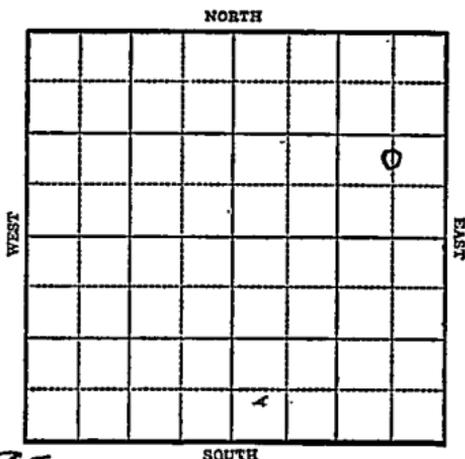

Elev. 1795

R E P O R T

1943

6/9 Location.

6/16 Rotary

6/23 10' @ 227'
DrTg. 1980'

6/30 Lens 2911
Arb. 3272
T.D. 3282'

ABANDONED

Ellsworth

KANSAS

Map No. 53 Sec. 14 Twp. 17 R. 10W

Well No. 2 Peterman

Vickers Company

FIRST REPORT Contractor

C NL SE NE

SECTION PLAT

_____ Ft. from N. Line

990 Ft. from S. Line

660 Ft. from E. Line

_____ Ft. from W. Line

			o

STOLTENBERG POOL

Location XXX

Rig up _____

Drilling and Remarks:

RECORD

Cased _____ in., _____ ft.

Sand _____

Gas _____

Oil _____

Total Depth _____

PRODUCTION

1st 24 hrs. Nat. _____

1st 24 hrs. after shot _____

Gas _____ Cu. Ft.

Dry Hole _____

Abandoned _____

Date _____

JUN 9 1943 19

S. J. LEWIS Scout

Ellsworth

KANSAS

Map No. 55 Sec. 14 Twp. 17 R. 10W

Well No. 2 Peterman

Vickers Company

ABANDONED Contractor

C NL SE NE

SECTION PLAT

_____ Ft. from N. Line

990 Ft. from S. Line

660 Ft. from E. Line

_____ Ft. from W. Line

			o

STOLTENBERG POOL

Location _____

Rig up _____

Drilling and Remarks:

Leas 2911

Ac 83272

RECORD

Cased _____ in., _____ ft.

Sand _____

Gas _____

Oil _____

Total Depth 3282

PRODUCTION

1st 24 hrs. Nat. _____

1st 24 hrs. after shot _____

Gas _____ Cu. Ft.

Dry Hole _____

Abandoned _____

Date

JUN 3 0 1943

19

S. J. LEWIS Scout