

Section 14 Township 17 Range 10WWell No. #1 FrevertCompany Mid-Plains & Veeder

NORTH

			0				

WEST

EAST

SOUTH

Ellsworth

Sec. 14 Twp. 17 R. 10W

Well No. #1 Frevert Farm ✓

Mid-Plains & Veeder Company

Veeder - Contr. Contractor

Semi Wildcat


 Ft. from N. Line

330' Ft. from S. Line

330' Ft. from E. Line

 Ft. from W. Line

SE SE NW

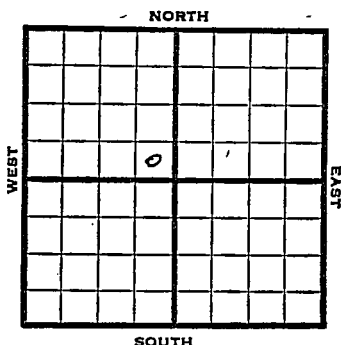


1952 Elev. 1785' REPORT

1/23 Spud 1-11-52
8" @ 307
Anhy 720
Heeb. 2798
Br L 2905
Lans. 2922
Cong. 3240
Arb. 3265
Circ @ 3275

1/30 Spud 1-11-52
D&A TD 3293
8" @ 307 Anhy 720 Heeb. 2798
Br Li 2905 Lans. 2922 Cong. 3240
Arb. 3265
DST 3270-93 open $\frac{1}{2}$ hr. rec. 480'
drlg. mud & sul. wtr.
D&A

ABANDONED

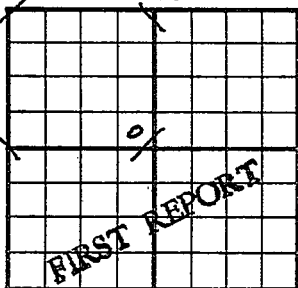County **Ellsworth** State **Kansas**Sec. **14** (Blk.) **17** (Sur.) **10W** Map No.Operator **Mid-Plains & Veeder**Well No. **1** Farm **Prevert**Elev. **1785** Location **SE SE NW****330** Ft. From **S** Line **NW****330** Ft. From **E** Line Quarter1st. Report **JAN 23 1952**

Completion


Remarks

Veeder - Contr.Spudding Date **1-11-52**

Drlg. Data

Semi Wildcat**8" @ 307 Anhy 720 Heeb 2798 BrL 2905****Lens 2922 Cong 3240 Arb 3265 Circ @ 3275****J. E. TYRA**

County Ellsworth State Kansas
 Sec. 14 (Blk. 17 (Sur. 10W Map No.
 (Twp.) (Rge.)
 Operator Mid-Plains & Veeder
 Well No. 1 Farm Frevert
 Elev. 1785 Location SE SE NW

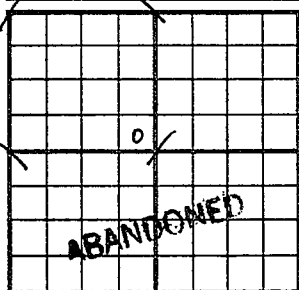

330 Ft. From S Line NW

330 Ft. From E Line Quarter

1st. Report

Completion JAN 30 1952

Remarks Semi Wildcat
Veeder - Contr.

Spudding Date 1-11-52

Drlg. Data D & A TD 3293

8" @ 307 Anhy 720 Heeb. 2798

Br. lime 2905 Lans. 2922 Cong. 3240

Arb. 3265 DST 3270-93 open $\frac{1}{2}$ hr.

Rec. 480' drlg. mud & sul. water

D & A

J. G. McGEHEE