

KANSAS

Form 51—5M—7-40—Palace

Ellsworth


Section 14 Township 17 Range 10-W

Well No. #1 Peterman

Company Vickers

Stratmann Pool

NORTH

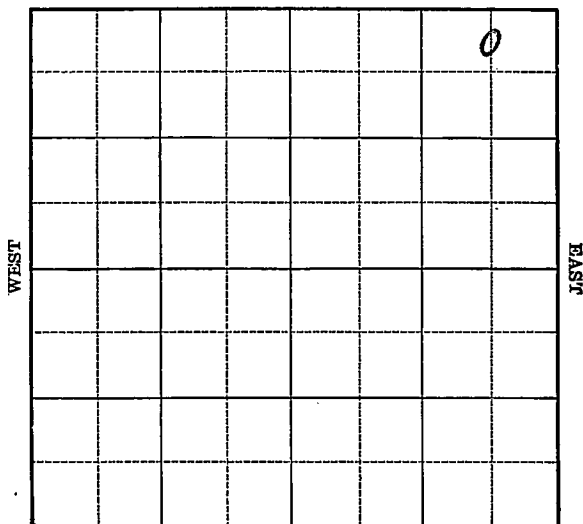

SOUTH

Map No. _____ Sec. 14 Twp. 17 R. 10WWell No. 1 PetermanVickers

Company

Contractor

FIRST REPORT

C N L NE NE

330 Ft. from N. Line


_____ Ft. from S. Line

660 Ft. from E. Line

_____ Ft. from W. Line

STRATMANN POOL

SECTION PLAT

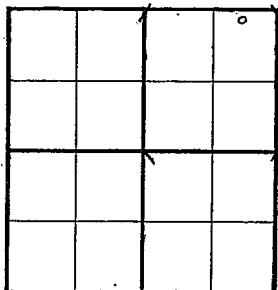

Location _____

Rig up _____

Drilling and Remarks:

Derrick

RECORD

Cased _____ in., _____ ft.

Sand _____

Gas _____

Oil _____

Total Depth _____

PRODUCTION

1st 24 hrs. Nat. _____

1st 24 hrs. after shot _____

Gas _____ Cu. Ft.

Dry Hole _____

Abandoned _____

Date

AUG 21 1940₁₉S. J. LEWIS Scout

Map No. 55 Sec. 14 Twp. 17 R. 10WWell No. 1 PetermanVickers Petroleum CompanyContractor**COMPLETED****SECTION PLAT****C N L NE NE**330 Ft. from N. Line Ft. from S. Line660 Ft. from E. Line Ft. from W. Line**STRATMAN POOL**

			2

Location Rig up

Drilling and Remarks:

*Ar 8 3263**7" @ 3263**4000 acail**Pump 48 P.S.***RECORD**Cased in., ft.Sand Gas Oil Total Depth 3286**PRODUCTION**1st 24 hrs. Nat. 1st 24 hrs. after shot Gas Cu. Ft.Dry Hole Abandoned

Date

SEP 25 194019S. J. LEWIS Scout