

Ellsworth


FORM 51 IOM 12-46 PETROL

KANSAS

Section 14 Township 17 Range 10W

Well No. 3 Peterman

Company Vickers

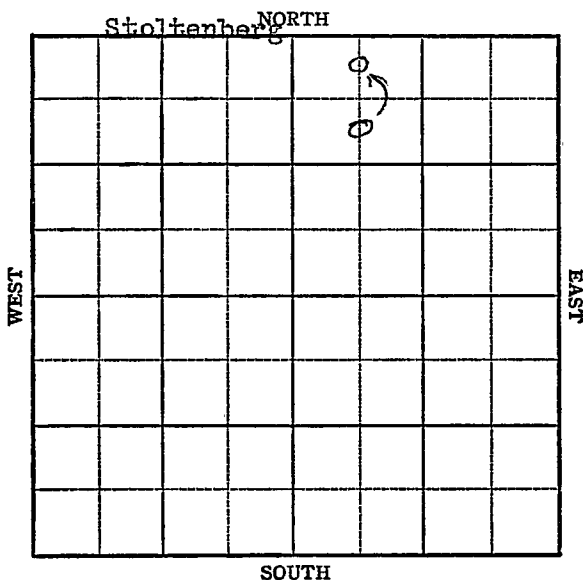

KANSAS Ellsworth

Sec. 14 Twp. 17 R. 10W

Well No. #3 Peterman Farm

Vickers Company

Stoltenberg


330  
290 Ft. from N. Line

\_\_\_\_\_ Ft. from S. Line

\_\_\_\_\_ Ft. from E. Line

660 Ft. from W. Line

C N L NW NE

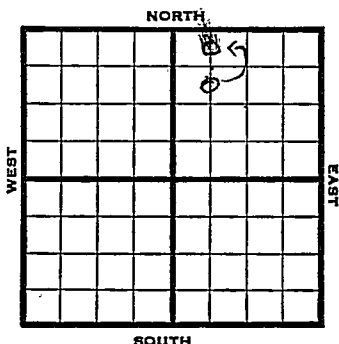

1947 Elev. 1770: REPORT

8/27 Surface hole.

9/3 8" @ 212  
Drlg 2000

9/10 Lansing 2878'  
Arbuckle 3247'  
Drlg. 3550'  
SWD

9/17 Arbuckle 3247'  
5" @ 3291'  
SWD  
Total Depth 3607'

ABANDONED

Map No. 55 Sec. 14 Twp. 17 R. 10W

Well No. 3 Peterman

Vickers Company

CORRECTION Contractor

C N L NW NE

SECTION PLAT

|   |   |   |  |
|---|---|---|--|
|   |   | o |  |
|   |   |   |  |
|   |   |   |  |
| J | 1 | 1 |  |

330 Ft. from N. Line

\_\_\_\_\_ Ft. from S. Line

\_\_\_\_\_ Ft. from E. Line

660 Ft. from W. Line

Ellsworth County

Location \_\_\_\_\_

Rig up \_\_\_\_\_

Drilling and Remarks:

Had spotted

C S L NW NE

RECORD

Cased \_\_\_\_\_ in., \_\_\_\_\_ ft.

Sand \_\_\_\_\_

Gas \_\_\_\_\_

Oil \_\_\_\_\_

Total Depth \_\_\_\_\_

PRODUCTION

1st 24 hrs. Nat. \_\_\_\_\_

1st 24 hrs. after shot \_\_\_\_\_

Gas \_\_\_\_\_ Cu. Ft.

Dry Hole \_\_\_\_\_

Abandoned \_\_\_\_\_

Date

AUG 27 1947 19

S. J. LEWIS

Scout

Map No. \_\_\_\_\_ Sec. 14 Twp. 17 R. 10W

Well No. 3 Peterman


Vickers Company

**FIRST REPORT**

Contractor

C N L NW NE

**SECTION PLAT**

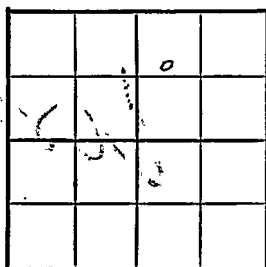

990 Ft. from N. Line

\_\_\_\_\_ Ft. from S. Line

\_\_\_\_\_ Ft. from E. Line

660 Ft. from W. Line

Ellsworth County

Location \_\_\_\_\_

Rig up \_\_\_\_\_

Drilling and Remarks:

surface hole

*CH*

**RECORD**

Cased \_\_\_\_\_ in., \_\_\_\_\_ ft.

Sand \_\_\_\_\_

Gas \_\_\_\_\_

Oil \_\_\_\_\_

Total Depth \_\_\_\_\_

**PRODUCTION**

1st 24 hrs. Nat. \_\_\_\_\_

1st 24 hrs. after shot \_\_\_\_\_

Gas \_\_\_\_\_ Cu. Ft.

Dry Hole \_\_\_\_\_

Abandoned \_\_\_\_\_

Date

AUG 27 1947

19

S. J. LEWIS

Scout

Map No. 55 Sec. 14 Twp. 17 R. 10W

Well No. 3 Peterman

Vickers Company

**ABANDONED**

Contractor

C N L NW NE

*E1,1770*  
**SECTION PLAT**

330 Ft. from N. Line

         Ft. from S. Line

         Ft. from E. Line

660 Ft. from W. Line

|  |  |   |  |
|--|--|---|--|
|  |  | o |  |
|  |  |   |  |
|  |  |   |  |
|  |  |   |  |

Ellsworth County

Location         

Rig up         

Drilling and Remarks:

*Ref 3247*

*5" @ 3291*

*BNJ*

**RECORD**

Cased          in,          ft.

Sand         

Gas         

Oil         

Total Depth 3607

**PRODUCTION**

1st 24 hrs. Nat.         

1st 24 hrs. after shot         

Gas          Cu. Ft.

Dry Hole         

Abandoned         

Date

SEP 17 1947 19 S. J. LEWIS Scout.