

KANSAS


FORM 51 5M 1-42 PETROL

Ellsworth

Section 14 Township 17 Range 10-W

Well No. #1 Shepman

Company Atlantic

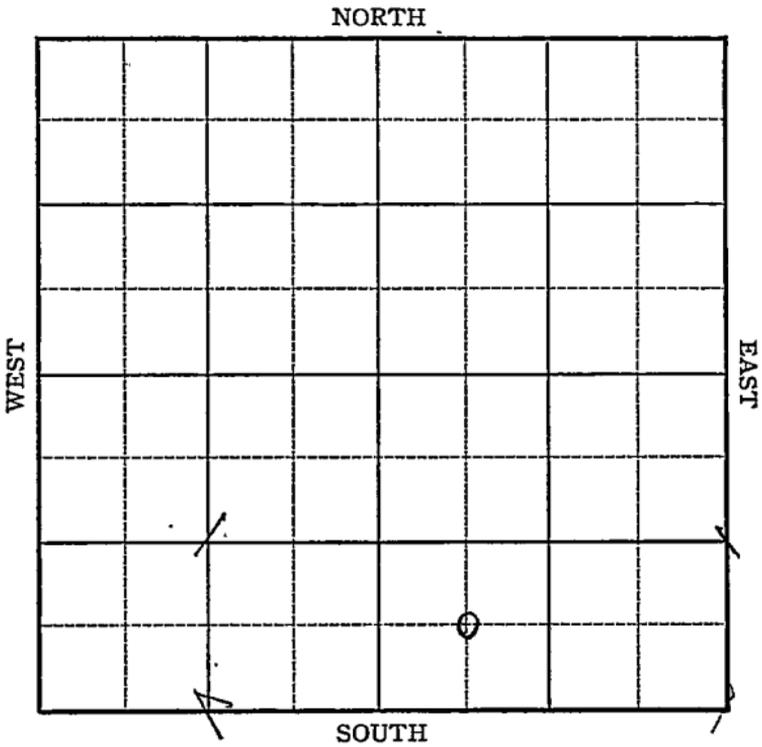

Sec. 14 Twp. 17 R. 10-W

Well No. #1 Shepmann Farm _____

Atlantic Company _____

Company


_____ Ft. from N. Line

660 Ft. from S. Line

_____ Ft. from E. Line

660 Ft. from W. Line

Bloomer Pool

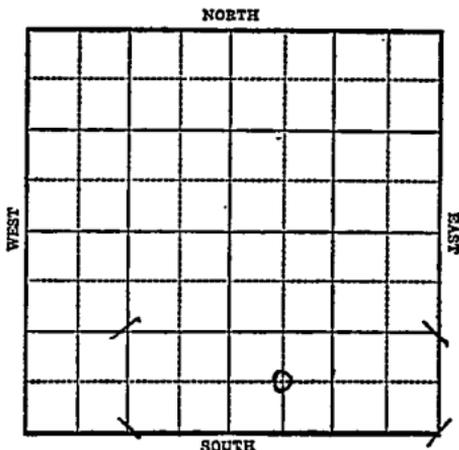

1943

Edw. 1785 REPORT

7/28 Rotary

8/4 10" @ 278'
Drlg. 2075'

8/11 Drlg. 3070'
Lans 2923

8/18 Arb 3252 $\frac{1}{2}$
7" @ 3252 $\frac{1}{2}$
T.D. 3255 SSO
Rust

8/25 2600 acid 1 $\frac{1}{2}$ oil & 2 water per hr
hr 16 hrs.

9/1 " "

9/8 Arb 3252 $\frac{1}{2}$
7" @ 3252 $\frac{1}{2}$
HFW
T.D. 3287

ABANDONED

KANSAS

Ellsworth

Map No. 53 Sec. 14 Twp. 17 R. 10WWell No. 1 ShepmanAtlantic

Company

FIRST REPORT

Contractor

C SW SE

SECTION PLAT

		o	

_____ Ft. from N. Line

660 Ft. from S. Line

_____ Ft. from E. Line

660 Ft. from W. Line

BLOOMER POOL

Location _____

Rig up _____

Drilling and Remarks:

Rotary

RECORD

Cased _____ in., _____ ft.

Sand _____

Gas _____

Oil _____

Total Depth _____

PRODUCTION

1st 24 hrs. Nat. _____

1st 24 hrs. after shot _____

Gas _____ Cu. Ft.

Dry Hole _____

Abandoned _____

Date

JUL 28 1943

19

S. J. LEWIS

Scout

KANSAS
 Map No. _____ Sec. 14 Twp. 17 R. 10W

Well No. 1 Shepmann

Atlantic Company

ABANDONED Contractor

SECTION PLAT

C SW SE

_____ Ft. from N. Line

660 Ft. from S. Line

_____ Ft. from E. Line

660 Ft. from W. Line

		6	

BLOOMER POOL

Location _____

Rig up _____

Drilling and Remarks:

Ar 83252 1/2

7" @ 3252 1/2

HFW.

RECORD

Cased _____ in. _____ ft.

Sand _____

Gas _____

Oil _____

Total Depth 3289

PRODUCTION

1st 24 hrs. Nat. _____

1st 24 hrs. after shot _____

Gas _____ Cu. Ft.

Dry Hole _____

Abandoned _____

Date

SEP 8 1943 19 S. I. LEWIS Scout