


Ellsworth 9W

Map No. KANSAS Sec. 14 Twp. 17 R. 9W

Well No. 12 Empire Oil Farm Company

NORTH

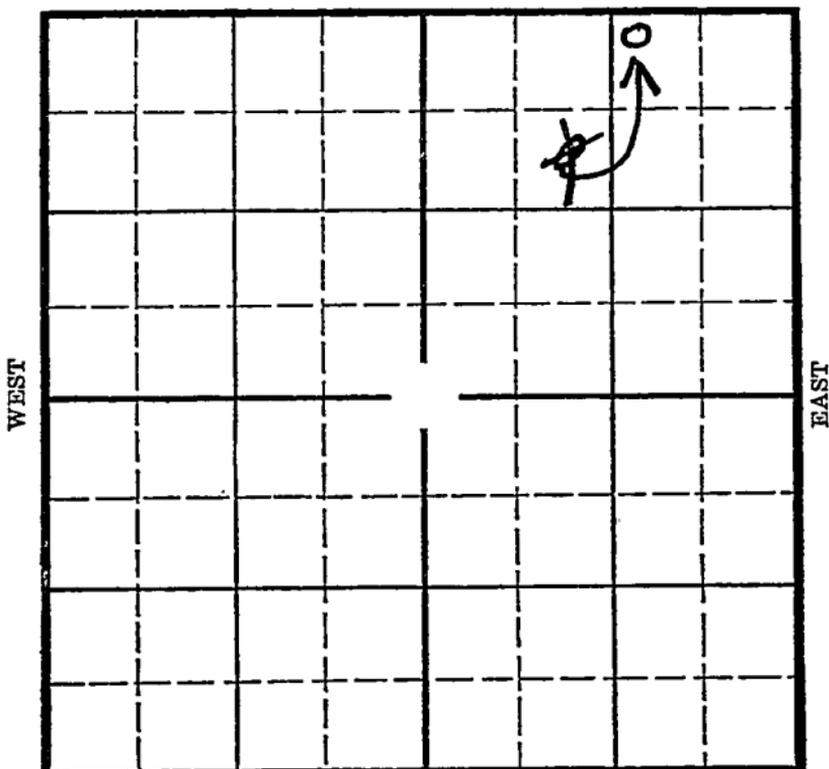

SOUTH

O. W. D. D

Location _____
Drilling Remarks _____

Rig Up _____
Drilling Remarks _____

RECORD

PRODUCTION

Cased _____ in. _____ ft.
Sand _____
Gas _____
Oil _____
Total Depth _____


1st 24 hrs. Nat. _____
1st 24 hrs. after shot _____
Gas _____ cu. ft.
Dry Hole _____
Abandoned _____

Ellsworth

Map No. KANSAS Sec. 14 Twp. 17 R. 9W

Well No. 17-Rolf Farm _____
Empire Oil Company _____

330
990 Ft. from N. Line
____ Ft. from S. Line
990 Ft. from E. Line
990 Ft. from W. Line

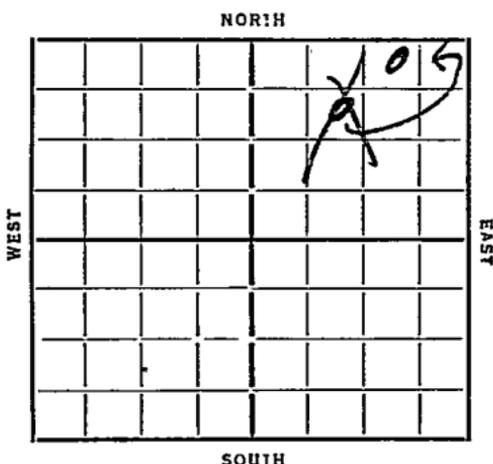

Elev. 1796

Date	REPORT	O. W. D. D.
1935	Location	
8/21	B.R.	
8/29	10" 208 WOC.	
9/6	Temp 3184 6" 3184 Red	
10/3	Oil 3211 450 3211-12	
10/10	3214 13 Oil 9 68 W.	
11/1	pulling tubing	
11/7	Log 3287	
11/14	Log 3370	
11/21	C.D.	
11/29	W.R. 6"	
12/6	Log 3240	
12/13	TD 3370 Log up lost tools at 3245	
12/19	Log	
12/26	5 3/16 3260 WOC	
12/36	CO 3294	
1/10	187 Bls Wth 3359	
	187 " " 3380	
	Log 3412	
1/17	TD 3515 275 Bls Wth P/H	
	Acidizing	

OVER

1/24 2000 acid
dely 3632

1/31 dely 3808

2/5 Regan 3740
TD 3855

2000 acid
completed for water
disposal well.

ABANDONED

O. W. D. D

1936

11/10--Old T. D. 3544

Regan 3844

T. D. 4045

Water Disposal

11/19--

11/25 T. D. 4045'. Take 65 bbls.
water per hr. Water disposal
well.

ABANDONED

Eldworth

Map No. 45 Sec. 14 Twp. 17 R. 9W

Well No. 12-Rolf

Empire oil Company

Contractor

FIRST REPORTS

SECTION PLAT

990 Ft. from N. Line

..... Ft. from S. Line

..... Ft. from E. Line

990 Ft. from W. Line

		o	

Location

Rig up.....

Drilling and Remarks:

RECORD

Cased.....in.,ft.

Sand.....

Gas.....

Oil.....

Total Depth.....

PRODUCTION

1st 24 hrs. Nat.....

1st 24 hrs. after shot.....

Gas.....Cu. Ft.

Dry Hole.....

Abandoned.....

~~ORVAL MANNING~~

Date

8-21-35 192.....

Scout

Map No. 43 Sec. 14 Twp. 17 R. 9W

Well No. 12-1001

Empire oil

Company

Contractor

CORRECTION

SECTION PLAT

			①

330 Ft. from N. Line

Ft. from S. Line

990 Ft. from E. Line

Ft. from W. Line

CORRECTION

Location

Rig up

Drilling and Remarks:

formerly Reported
as SE NW NE

RECORD

Cased.....in.,ft.

Sand.....

Gas.....

Oil.....

Total Depth.....

PRODUCTION

1st 24 hrs. Nat.....

1st 24 hrs. after shot.....

Gas..... Cu. Ft.

Dry Hole.....

Abandoned.....

Date

8-28-35 192

ORVAL MANN SCHRECK

Scout

Map No. 45 Sec. 14 Twp. 17 R. 9W

Well No. 12 - Rath

Empire Company

Contractor

SECTION PLAT

330 Ft. from N. Line

..... Ft. from S. Line

990 Ft. from E. Line

..... Ft. from W. Line

			0

~~ABANDONED~~
ABANDONED

Location.....

Rig up.....

Drilling and Remarks:

2000 acid
Completed for
Water disposal
well

RECORD

Cased..... in., ft.

Sand Regen 3740

Gas.....

Oil.....

Total Depth 3855

PRODUCTION

1st 24 hrs. Nat.....

1st 24 hrs. after shot.....

Gas..... Cu. Ft.

Dry Hole.....

Abandoned.....

Date

FEB 5 1936

ORVAL MANNSCHRECK

..... 192..... Scout

Map No. 45 Sec. 14 Twp. 17 R. 9W.

Well No. 12 R. 1/4.

Empire

Company

Contractor

SECTION PLAT

			0

330. Ft. from N. Line

_____ Ft. from S. Line

_____ Ft. from E. Line

380 Ft. from W. Line

FIRST REPORT

Oil Well

RECORD

Location _____

Rig up _____

Drilling and Remarks:

Oct 6 1934

Rigan 3740

Water Disposal

Cased _____ in., _____ ft.

Sand _____

Gas _____

Oil _____

Total Depth 4045

PRODUCTION

1st 24 hrs. Nat. _____

1st 24 hrs. after shot _____

Gas _____ Cu. Ft.

Dry Hole _____

Abandoned _____

Date

NOV 10 1936 19

S. J. LEWIS Scout

E. Lawrence KANSAS

Map No. 45 Sec. 14 Twp. 17 R. 9W

Well No. 12. Poly.

Empire Company

Contractor

SECTION PLAT

			0

330 Ft. from N. Line

_____ Ft. from S. Line

990 Ft. from E. Line

_____ Ft. from W. Line

ABANDONED

ABANDONED

Location _____

Rig up _____

Drilling and Remarks:

*take 65 gal
water per hr*

*Water Disposal
well.*

RECORD

Cased _____ in., _____ ft.

Sand _____

Gas _____

Oil _____

Total Depth 4045

PRODUCTION

1st 24 hrs. Nat. _____

1st 24 hrs. after shot _____

Gas _____ Cu. Ft.

Dry Hole _____

Abandoned _____

Date

NOV 25 1936

19

S. J. LEWIS Scout