



KANSAS

Ellsworth

Map No. \_\_\_\_\_ Sec. 14 Twp. 17 R. 9W

Well No. 8-Rolfs Farm \_\_\_\_\_


Empire Oil Company  
Cities-Service Oil NORTH

\_\_\_\_\_ Ft. from N. Line

990 Ft. from S. Line

\_\_\_\_\_ Ft. from E. Line

990 Ft. from W. Line

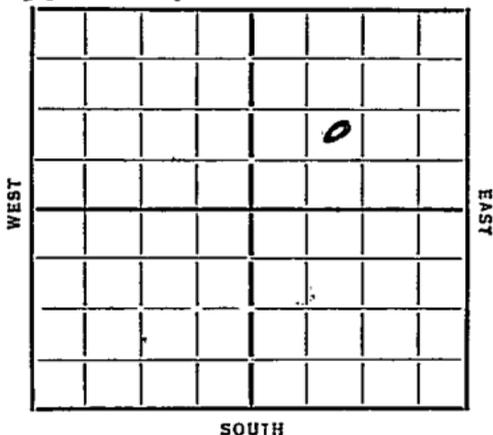

Elev. 1790

Date

REPORT

O. W. P. B.

7/3/5

7/10

7/18

8/8

8/15

8/21

Rog

12" 1240

Simpson 3170

7" 3175 Ruth

Oil 3183 T 7 3186

HFO, 1000 acid

Oil 3183 T 7 3186

1000 acid

1623 Pbls.

COMPLETED

OVER

1939

O. W. P. B.

1/11

No Lans. Top available.

Arb. 3183-86' T.D.

Old Potential 1623 bbls.

Went to water.

P. B. 3082'.

Perf. 80 shots 3035-50'.

Pay 3039-49'.

2000 acid.

Pump 35 oil 6 hrs.

Minimum well.

FIRST REPORT

*and*

COMPLETED

*Edworth*  
 Map No. 45 Sec. 14 Twp. 17 R. 9W  
 Well No. 8-Ralphs  
Empire oil Company  
 Contractor

FIRST REPORTS

SECTION PLAT

.....Ft. from N. Line

990 Ft. from S. Line

.....Ft. from E. Line

990 Ft. from W. Line

		0	

Location.....

Rig up.....

Drilling and Remarks:

*Rog*

RECORD

Cased.....in., .....ft.

Sand.....

Gas.....

Oil.....

Total Depth.....

PRODUCTION

1st 24 hrs. Nat.....

1st 24 hrs. after shot.....

Gas.....Cu. Ft.

Dry Hole.....

Abandoned.....

Date

7-10-95 192..... **ORVAL MANN-SCHRECK** Scout

*Ellsworth*  
Form 26 - 1st Ed. - 9-26

1575 S

Map No. *45* Sec. *14* Twp. *17* R. *9W*

Well No. *8-Rolls*

*Empire oil*

Company

Contractor

**COMPLETED**

**SECTION PLAT**

..... Ft. from N. Line

*990* Ft. from S. Line

..... Ft. from E. Line

*990* Ft. from W. Line

		0	

Location.....

Rig up.....

Drilling and Remarks:

*1000 acid*

*1623 Hk*

**RECORD**

Cased..... in., ..... ft.

Sand *Sil* *3183*

Gas.....

Oil.....

Total Depth. *3186*

**PRODUCTION**

1st 24 hrs. Nat.....

1st 24 hrs. after shot.....

Gas..... Cu. Ft.

Dry Hole.....

Abandoned.....

Date

*8-21-35* 192.....

**MANNSCHECK**

Scout

Ellsworth **KANSAS**Map No. 45 Sec. 14 Twp. 17 R. 9WWell No. 8 RolfsCities Service Oil Company

Contractor

**FIRST REPORT & COMPLETED**

SECTION PLAT

NE SW NE

\_\_\_\_\_ Ft. from N. Line

990 Ft. from S. Line

\_\_\_\_\_ Ft. from E. Line

990 Ft. from W. Line

	.	o	

EDWARDS POOL

Location \_\_\_\_\_

Rig up \_\_\_\_\_

Drilling and Remarks:

OWPB (NO LANS TOP AVAILABLE)

Arb. 3183-86 TD

Old. Poten. 1623

went to water

P.B. 3082

Perf. 80 shots

3035-50

Pay 3039-49

2000 acid

Pump 35 oil-6 hrs.

Date Minimum well

## RECORD

Cased \_\_\_\_\_ in., \_\_\_\_\_ ft.

Sand \_\_\_\_\_

Gas \_\_\_\_\_

Oil \_\_\_\_\_

Total Depth \_\_\_\_\_

## PRODUCTION

1st 24 hrs. Nat. \_\_\_\_\_

1st 24 hrs. after shot \_\_\_\_\_

Gas \_\_\_\_\_ Cu. Ft.

Dry Hole \_\_\_\_\_

Abandoned \_\_\_\_\_

JAN 11 1938 19 \_\_\_\_\_ H. D. Hatfield Scout