


Map No. 11 Sec. 14 Typ. 17 R. 9W

Well No. 11-14-17-9W Farm Empire Oil

Company Citico Service Corp

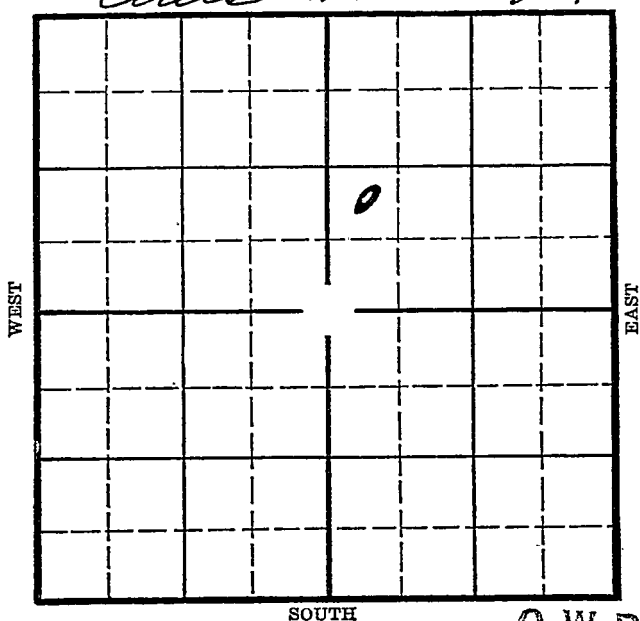

O. W. P. B.

Location _____

Drilling Remarks _____

Rig Up _____

Drilling Remarks _____

RECORD

Cased _____ in. _____ ft.

Sand _____

Gas _____

Oil _____

Total Depth _____

PRODUCTION

1st 24 hrs. Nat. _____

1st 24 hrs. after shot _____

Gas _____ cu. ft.

Dry Hole _____

Abandoned _____

Ellsworth

Map No. KANSAS Sec. 14 Twp. 17 R. 9W

Well No. 11- Rolfe Farm

Empire Oil Company
Cities Service Oil

Ft. from N. Line

990 Ft. from S. Line

Ft. from E. Line

330 Ft. from W. Line

Elev. 1787

WEST

EAST

SOUTH

Date 1935 REPORT O. W. P. B.

8/14 Moving In

8/22 Rot Rig

8/29 12" 200 WOC

9/6 2040

10/2 3200

77 320 2 1/2

1751 Oil

270 Water

COMPLETED


OVER

1939
2/21

O. W. P. B.

Old T. D. 3202 $\frac{1}{2}$ '
Arb. 3200'.
Orig. potential 1751 oil &
270 water.
P. B. to 3088' in Lams.
100 shots 3030-49'
Pay 3034-43'
60 shots 3033-44'
3000 acid.
Pumped 45 bbls. 12 hrs.
No Water.

FIRST REPORT

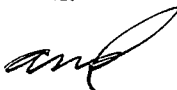

COMPLETED

Ellsworth KANSAS
 Map No. *45* Sec. *14* Twp. *17* R. *9N*
 Well No. *11- Rolfs*
Empire oil Company

FIRST REPORT

Contractor

SECTION PLAT

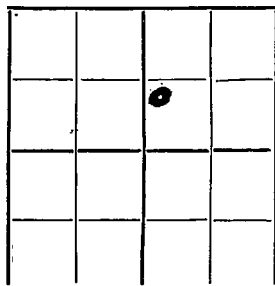

.....Ft. from N. Line
990
Ft. from S. Line
Ft. from E. Line
330
Ft. from W. Line

FIRST REPORT

Location.....

Rig up.....

Drilling and Remarks:

Moving in

RECORD

Cased.....in.,ft.

Sand.....

Gas.....

Oil.....

Total Depth.....

PRODUCTION

1st 24 hrs. Nat.....

1st 24 hrs. after shot.....

Gas.....Cu. Ft.

Dry Hole.....

Abandoned.....

Date

ORVAL MANNSCHRECK

8-14-35 192.....

Scout

Map No. 45 Sec. 14 Twp. 17 R. 9WWell No. 11-RalphEmpire oil Company

Contractor

COMPLETED

SECTION PLAT

Ft. from N. Line

990 Ft. from S. Line

Ft. from E. Line

330 Ft. from W. Line

		0	

Location

Rig up

Drilling and Remarks:

1751 oil
270 water

RECORD

Cased: in. ft.Sand oil 3200

Gas

Oil

Total Depth 3202 1/2

PRODUCTION

1st 24 hrs. Nat.

1st 24 hrs. after shot

Gas Cu. Ft.

Dry Hole

Abandoned

Date

ORVAL MANNSCHRECK

10-2-35 192

Scout

Map No. 45 Sec. 14 Twp. 17 R. 9WWell No. 11 Rolfs

Cities Service Oil

Company

FIRST REPORT

Contractor

COMPLETED

SECTION PLAT

NW SW NE

_____ Ft. from N. Line

990 Ft. from S. Line

_____ Ft. from E. Line

330 Ft. from W. Line

		0	

EDWARDS POOL

Location _____

Rig up _____

Drilling and Remarks:

(See Over)

RECORD

Cased _____ in., _____ ft.

Sand _____

Gas _____

Oil _____

Total Depth _____

PRODUCTION

1st 24 hrs. Nat. _____

1st 24 hrs. after shot _____

Gas _____ Cu. Ft.

Dry Hole _____

Abandoned _____

Date

FEB 21 1939 19

H. D. Hatfield Scout

OWPB- OTD 3202 $\frac{1}{2}$

Arb. 3200

Orig. Poten. 1751 oil/270 water
PB 3088 in Lans.

100 shots 3030-49

Pay 3034-43

60 shots 3033-44

3000 acid.

Pumped 45/ 12hrs. No Water
Completed

Moody Flat Book
Geological Dept
Moody Map
Scarborough Map
France Map
Tracing
Cards
Misc Small Maps

Misc Small Maps
Cards
Tracing
France Map
Scarborough Map
Moody Map
Geological Dept
Moody Flat Book