


Ellsworth

KANSAS

SECTION 15 TOWNSHIP 17 RANGE 7W

WELL NO. #1 Fuller

COMPANY Natural Gas & Oil

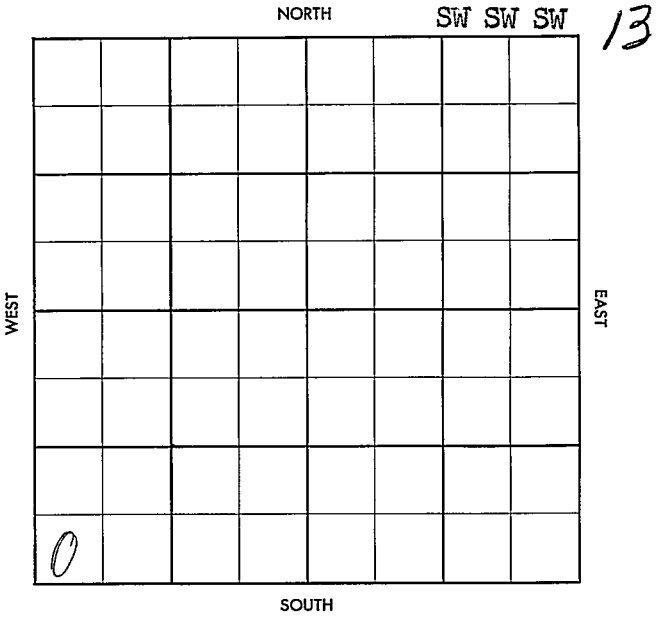

16 A-2

# WILDCAT

FORM 513 SUNRAY

County Ellsworth Elev. \_\_\_\_\_  
 Sec. 15 Twp. 17 Rgs. 7W  
 Company Natural Gas & Oil  
 FarmName Fuller No. 1

TOPS	DEPTH	LOG	DATUM
Anh.			
TP.			
H.			
Tr.			
Dg.			
Bl.			
L.			
K.C.			
B.K.C.			
Ce.			
C.			
M.			
M.			
K.			
Mz.			
Me.			
V.			
S.			
S.			
A.			
R.			
PE.			
G.			
T.D.			

Loc. in Sec. SW SW SW  
 Geol. \_\_\_\_\_  
 Contr. \_\_\_\_\_  
Sierra Drlg.  
 Pool Wildcat

FIRST REPORT  
 MAY 8 57  
 0

Date Comm. 5-6-57  
9# @ 283/250, WOC

*(Handwritten signature)*

Co.  
Lse.  
No.  
Sec.  
T.  
R.

County Ellsworth Elev. 1644  
 Sec. 15 Twp. 17 Rgs. 7W  
 Company Natural Gas & Oil  
 Farm Name Fuller No. 1

TOPS	DEPTH	LOG	DATUM	Loc. in Sec.
Anh.				SW SW SW
Ip.				
H.	2628			
Tr.				
Dg.				
Bl.				
L.	2788			Geol.
K.C.				Contr.
B.K.C.				Sierra Dr.
Ce.				
C.				
M.	3246			Pool
M.				Wildcat
K. 5/1	3286			
Mz.				
Me.				
V.				
S.				
S.				ABANDONE
A.				
R.				
Pe.				MAY 22 57
G.				
T.D.	3307			0

Date Comm. 5-6-57

9th @ 283/250, WOC MAY 15 57 D 2765  
 MAY 22 57 DST 3251-70 1hr rec  
 45' SW 981/20"

D & A.