

Form 51-5M-3-35-Mid-West

Map No. **KANSAS** Sec. **15** Twp. **17** R. **8-W**
Well No. **#1-Kafka** Farm
Skiles et al Company

NORTH

WEST

EAST

SOUTH

Location_____

Drilling Remarks

Rig Up_____

Drilling Remarks

RECORD

Cased _____ in _____ ft.

Sand_____

Gas_____

Oil

Total Depth

PRODUCTION

1st 24 hrs. Nat. _____

1st 24 hrs. after shot_____

Gas_____cu. ft._____


Drv Hole_____

Abandoned_____

Ellsworth

Map No. **KANSAS** Sec. *15* Twp. *17* R. *8W*
Well No. *1- Kapha* Farm _____
Shiler sub Company _____

330 Ft. from N. Line
_____ Ft. from S. Line
330 Ft. from E. Line
_____ Ft. from W. Line

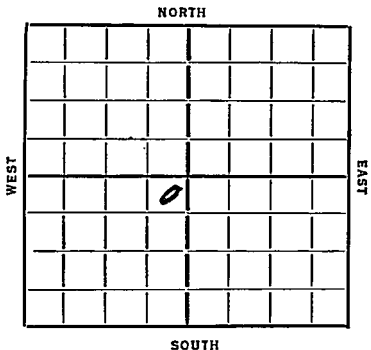

Elev. 1765

REPORT

1936
2/19 Bldg.
2/28 Rgn
3/6
3/13 12"-192 10"-368 Drlg 545
3/20 Drlg. 1730.
3/27 8"- 2190 Drlg. 2330'
4/2 HFW. 2740'-50' T.D. 2750' U.R. 8".
4/10 Top K.C.L. 2835' Drlg. 2840'
4/16 .Drlg. 3055'
4/23 3205', Base K.C. 3170'
4/29/36- Sil. 3319-27'
T.D. 3327'
HFW
D.&A.
ABANDONED

Map No. 45 Sec. 15 Twp. 17 R. 8WWell No. 1-KafkaSkiles et al Company

Contractor

FIRST REPORTS

330 Ft. from N. Line

Ft. from S. Line

330 Ft. from E. Line

Ft. from W. Line

SECTION PLAT

	0		

Location

Rig up

Drilling and Remarks:

Bedg

RECORD

Cased.....in.,ft.

Sand.....

Gas.....

Oil.....

Total Depth.....

PRODUCTION

1st 24 hrs. Nat.....

1st 24 hrs. after shot.....

Gas.....Cu. Ft.

Dry Hole.....

Abandoned.....

Date

2-19-36 192.....

ORVAL MANNSCHRECK

Scout

Map No. 45 Sec. 15 Twp. 17 R. 8NWell No. 1 KayikaSkiles & Co Company

Contractor


SECTION PLAT

330 Ft. from N. Line

Ft. from S. Line

330 Ft. from E. Line

Ft. from W. Line

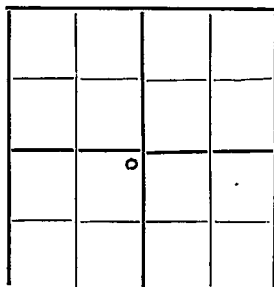

ABANDONED

Location

Rig up

Drilling and Remarks:

Sc 63319-27NFWJ & A

RECORD

Cased.....in.,ft.

Sand.....

Gas.....

Oil.....

Total Depth 3327

PRODUCTION

1st 24 hrs. Nat.....

1st 24 hrs. after shot.....

Gas.....Cu. Ft.

Dry Hole.....

Abandoned.....

Date

APR 29 1936

192

S. J. LEWIS

Scout