


KANSAS

Section 15 Township 17 Range 8W

Well No. 1 Kafka

Company Westgate-Greenland

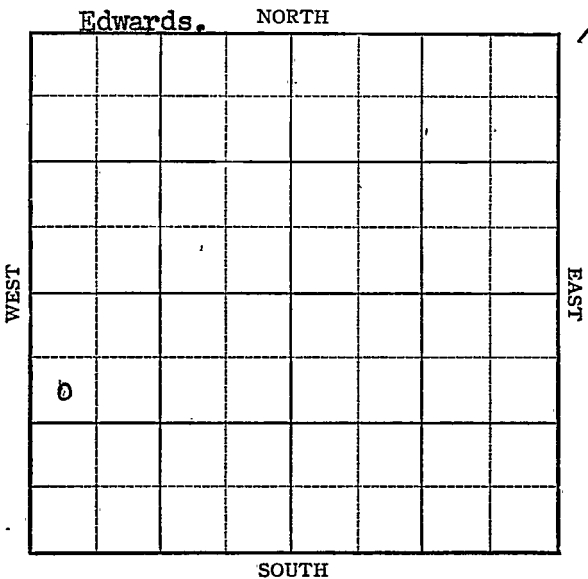

KANSAS

E 11sw 8th

Sec. 15 Twp. 17 R. 8

Well No. 1 Krafa Farm
Westgate-Greenland


Edwards Pool

990 Ft. from N. Line

Ft. from S. Line

Ft. from E. Line

330 Ft. from W. Line

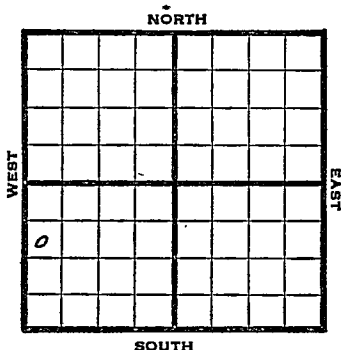

SW NW SW

1947

1776

REPORT

5/7 8" @ 193
Drlg. 606'.

5/12 Arb. 3284'
TD 3300'

ABANDONED

1952

O.W.W.O.

3/5 KC 2850 Arb. 3284 RTD 3300
Was D&A to DD with Rotary

3/11 DD 3311' Sch.

3/19 DST 3301-13 RTD 1 hr. 960' gas &
some mud cut oil 685' Sm & G cut
sulp wtr. 60' sulphr wtr
5" @ 3312 RUST

3/25 CO to TD S/ 5 BOPH Nat. to
PB & Perf.

4/1 Did not PB 32/3282-92 S/ 50 to
70 BO 10 hrs. 1600' off btm.
132 BOPD & trace wtr.

4/9 NR

4/23 Oil Well TD 3313'

KC 2850 Arb. 3284

OTD 3300' DD 3311'

DST 3301-13 open 1 hr. rec. 960' gas
& smco 685' sm & gcs

OVER

1952

4/23 60' sul. wtr. 5" @ 3312
CO to 3313' S/ 5 boph PB
32/ 3282-92 S/ 50 to 70 bo 10
hr.
Comp. 349 bopd 41% wtr.

COMPLETED

Map No. K 45 Sec. 15 Twp. 17 R. 8W

Well No. 1 Kafka

Westgate-Greenland Company

FIRST REPORT

Contractor

SW NW SW


SECTION PLAT

990 Ft. from N. Line

 Ft. from S. Line

 Ft. from E. Line

330 Ft. from W. Line

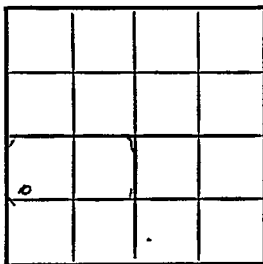

Ellsworth County

Location

Rig up

Drilling and Remarks:

8" @ 193

drlg. 606

RECORD

Cased in., ft.

Sand

Gas

Oil 2 1/2 M 11.2 1.2 M

Total Depth 2100

PRODUCTION

1st 24 hrs. Nat.

1st 24 hrs. after shot

Gas 1.2 M 11.2 1.2 M Cu. Ft.

Dry Hole

Abandoned

Date

MAY 7 1947 19

S. J. LEWIS Scout


7-1-1917





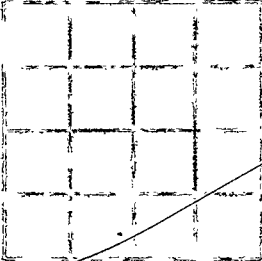





Misc. Small Maps

Cards

Tracing

France Map

Scarborough Map

Pierce Map

Geological Dept.

Pierce Post Book

Kansas Edwards Pool


Map No. 545 Sec. 15 Twp. 17 R. 8WWell No. 1 KafkaWestgate-Greenland

Company

ABANDONED

Contractor

SW NW SW

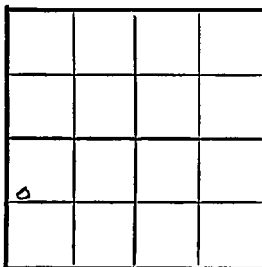E 11776
SECTION PLAT990 Ft. from N. Line Ft. from S. Line Ft. from E. Line330 Ft. from W. LineEllsworth CountyLocation Rig up

Drilling and Remarks:

CU 3284**RECORD**Cased in., ft.Sand Gas Oil Total Depth 3300**PRODUCTION**1st 24 hrs. Nat. 1st 24 hrs. after shot Gas Cu. Ft.Dry Hole Abandoned

Date

MAY 14 1947 19S. J. LEWIS

Scout

Misc. Small Maps 6
Cards RLB
Tracing J
France Map ✓
Scarborough Map ✓
Horse Map LM
Cecological Dept. ✓
Pierce Flat Book ✓

Scout Cards

Land Small Map

Land Wail Map

Tracings

France Map

Pierce Map

Misc.

MAR 7 1952

Orig. Date

County Ellsworth State Kansas

Sec. 15 (Blk. Twp.) 17 (Sur. Rge.) 8W Map No.

Operator Westgate-Greenland

Well No. 1 Farm Kafka

Elev.	1776	Location	SW NW SW
-------	------	----------	----------

COMPLETE

990 Ft. From N Line SW

330 Ft. From W Line Quarter

Ist. Report _____

Completion APR 23 1957

Remarks OWWO

O.W.W.O.

Spudding Date _____

Drilg. Data Oil well TD 3313

KC 2850 Arb. 3284 OTD 3300 DD 3311

DST 3301-13 open 1 hr. Rec. 960' gas

& smco 685' sm & gcsw 60' sul. water

5" @ 3312 CO to 3313 S/ 5 boph PB.

32/ 3282-92 S/ 50 to 70 bo 10 hr.

Comp. 349 bopd 41% water

Scout Cards
Land Small Map
Land Wall Map
Tracings
France Map
Pierce Map
Misc.

APR 30 1952

Drig. Data