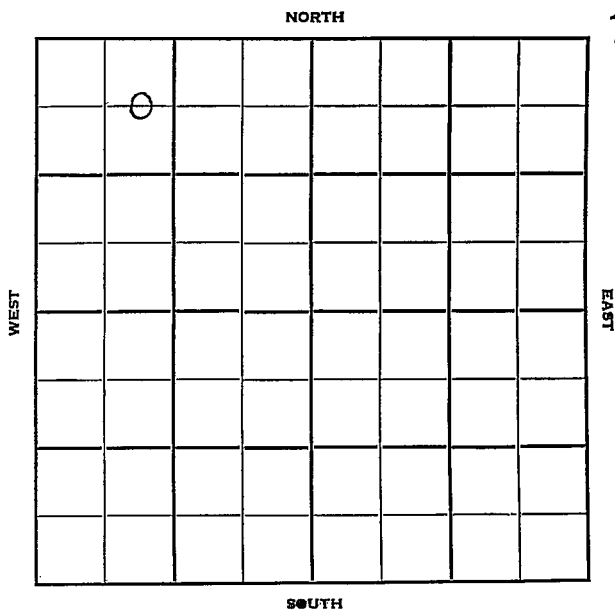


Section 15 Township 17 Range 8 WWell No. # 14 KafkaCompany Westgate-Greenland

Ellsworth

KANSAS

Sec. 15 Twp. 17 R. 8W

Well No. #4 Kafka Farm

Westgate-Greenland Company

Jackson Drlg. - Contr. Contractor

Edwards Pool


660' Ft. from N. Line

 Ft. from S. Line

 Ft. from E. Line

990' Ft. from W. Line

C E L N W W

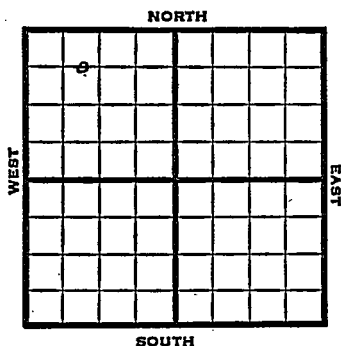

1951

Elev. 1707' REPORT

4/18

Spud 4-13-51

8" @ 213

Drlg. 2080'

6/8

Spud 4-13-51

Oil Well TD 3225

8" @ 213

Heeb. 2621 Br Lime 2743

Lans. 2760 Cong. 3169-76

DST 3170-79 opn 40 min.

Rec. 8' mud

Sand 3189-93 Arb. 3209

DST 3206-16 opn 1 hr

Rec. 75' o & gcm 5" @ 3210

TD 3225 FU 700' oil 5 hr

S/110 bo 6 hr. Comp. 481 bopd

COMPLETED

County Ellsworth State Kansas
 Sec. 15 (Blk.) 17 (Sur.) 8W Map No.
 (Twp.)
 Operator Westgate-Greenland
 Well No. 2 Farm Kafka
 Elev. _____ Location C E L NW NW

0							

FIRST REPORT

660 Ft. From N Line NW
990 Ft. From W Line Quarter

1st. Report APR 18 1951

Completion _____

Remarks _____

Jackson Drig. + Contr.

Spudding Date 4-13-51


Drig. Data _____

Edwards Pool

8" @ 213 drig. 2080

J. E. TYRA

County Ellsworth State Kansas
 Sec. 15 (Blk. 17 (Sur. 8W Map No.
 (Twp.) (Rge.)
 Operator Westgate-Greenland
 Well No. 4 Farm Kafka
 Elev. 1707 Location C E L NW NW

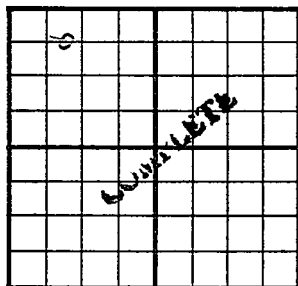

660 Ft. From N Line NW
990 Ft. From W Line Quarter

1st. Report

Completion JUN 6 1951

Remarks Edwards Pool

Jackson Drlg. - Contr.

Spudding Date 4-13-51

Drlg. Data Oil well TD 3225

8" @ 213 Heeb. 2621 Br. lime 2743

Lans. 2760 Cong. 3169-76 DST 3170-79

open 40 min. Rec. 8' mud Sand 3189-93

Arb. 3209 DST 3206-16 open 1 hr.

Rec. 75' o & gcm 5" @ 3210 TD 3225

FU 700' oil 5 hr. S/ 110 bo 6 hr.

Comp. 481 bopd

J. E. TYRA