


Section 15 Township 17 Range 8W

Well No. #5 Kafka

Company Westgate-Greenland

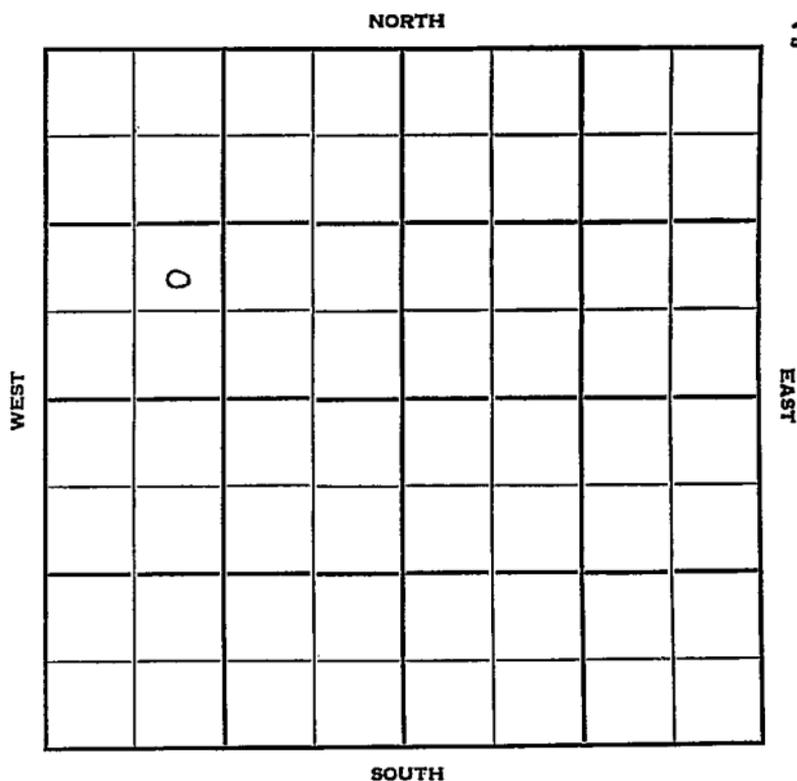

Ellsworth

KANSAS

Sec. 15 Twp. 17 R. 8W

Well No. #5 Kafka Farm

Westgate-Greenland Company

Jackson Drlg. - Contr. Contractor

North Edwards Pool


_____ Ft. from N. Line

990' Ft. from S. Line

_____ Ft. from E. Line

990' Ft. from W. Line

NE SW NW

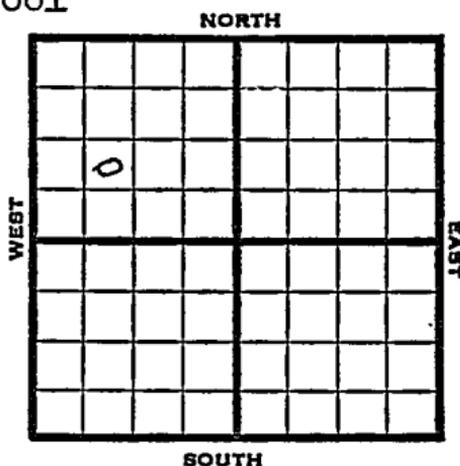

1951 Elev. 1748' REPORT

8/29 Spud 8-26-51
10" @ 200
WOC

10/3 Spud 8-26-51
Oil well TD 3288' 10" @ 200
Heeb. 2669' Br. lime 2788' Lans. 2809
B KC 3159' Simp. 3200' Arb. 3242-
88' 5" @ 3288' 96/3244-72
S/20 BOPH
Comp. depth. pot. 2505 BOPD

COMPLETED

