


Section 15 Township 17 Range 8 W

Well No. #1-A
#5 Kafka

Company Westgate-Greenland

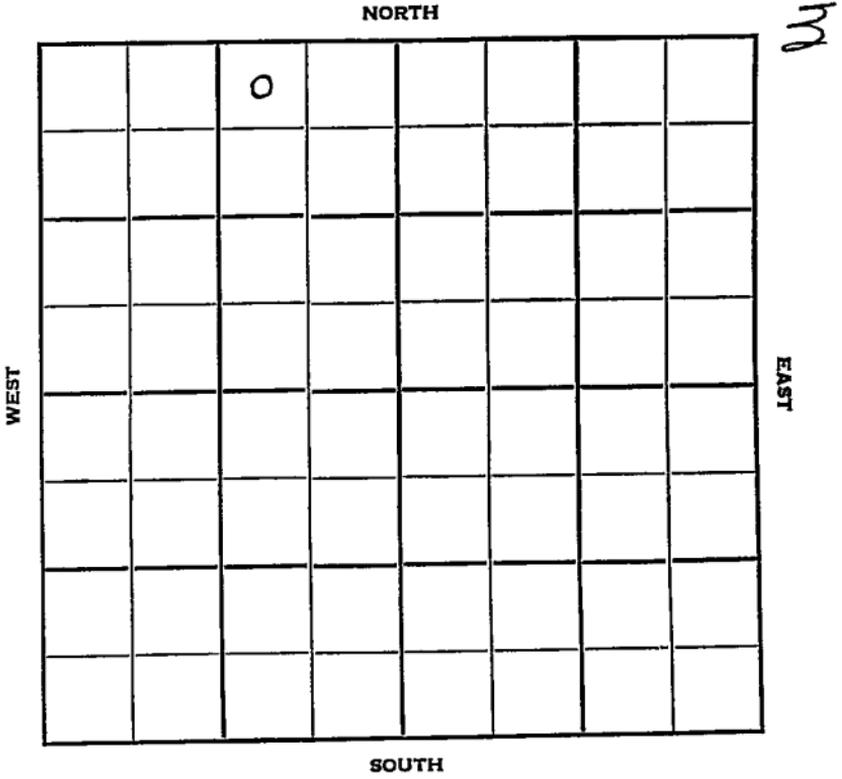

Ellsworth

KANSAS

Sec. 15 Twp. 17 R. 8 W ✓

Well No. #1 KAFKA "A"
#5 Kafka Farm

Westgate-Greenland Company

Jackson Drlg. Contractor

Edwards Pool


330 Ft. from N. Line

_____ Ft. from S. Line

990 Ft. from E. Line

_____ Ft. from W. Line

NW NE NW

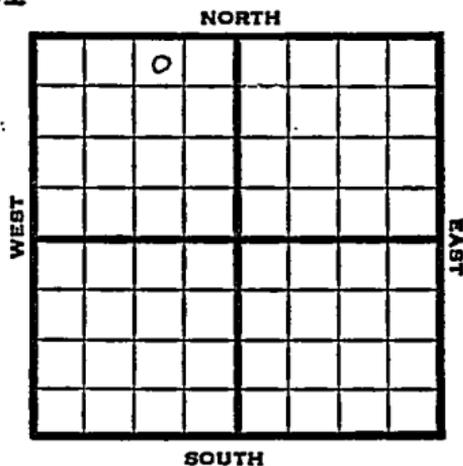

1951 Elev. 1732' REPORT

5/2 Spud 4-28-51
8" @ 211
Drlg. 1470'

6/27 Spud 4-28-51
Oil Well TD 3272
8" @ 211'
Heeb. 2639 Br Lime 2757
Lans. 2774 Viola 3164
Simp 3202 Arb. 3252
TD 3272 DST 3204-18
Rec. 30' mud DST 3204-56 Rec 85' mud
DST 3253-64 opn 1/2 hr. Rec. 2765'
oil 5" @ 3272 S/150 bo 4 hr
24/3248-58 S/150 bo 4 hr
Comp. 688 bopd

~~COMPLETE~~

County Ellsworth State Kansas

Sec. 15 (Blk. Twp.) 17 (Sur. Rge.) 8W Map No.

Operator Westgate-Greenland

Well No. 5 Farm Kafka

Elev. Location NW NE NW

		0				

330 Ft. From N Line NW

990 Ft. From E Line Quarter

1st. Report MAY 2 1951

Completion.

Remarks

Jackson Drlg. - Contr.

Spudding Date 4-28-51

Drlg. Data Edwards Pool

8" @ 211 drlg. 1470

J. E. TYR...

Map No. _____ Sec. 15 Twp. 17 R. 8WWell No. 1 Kafka "A"Westgate-Greenland Company**CORRECTION** Contractor

NW NE NW


330 Ft. from N. Line

_____ Ft. from S. Line

990 Ft. from E. Line

_____ Ft. from W. Line

SECTION PLAT

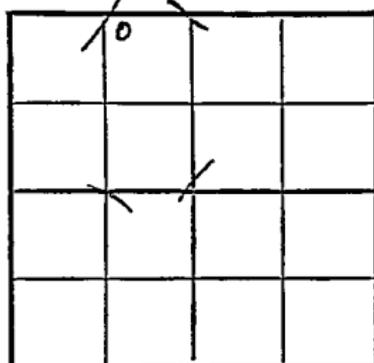

Ellsworth County

Location _____

Rig up _____

Drilling and Remarks:

Reported

#5 Kafka

RECORD

Cased _____ in., _____ ft.

Sand _____

Gas _____

Oil _____

Total Depth _____

PRODUCTION

1st 24 hrs. Nat. _____

1st 24 hrs. after shot _____

Gas _____ Cu. Ft.

Dry Hole _____

Abandoned _____

Date

JUN 6 1951 19J. E. TYRÄ

Scout

County Ellsworth State Kansas
 Sec. 15 (Blk. 17 (Sur. 8W (Twp.) (Rge.) Map No.
 Operator Westgate-Greenland
 Well No. 1 Farm Kafka "A"
 Elev. 1732 Location NW NE NW

0					

330 Ft. From N Line NW
990 Ft. From E Line Quarter
 1st. Report
 Completion JUN 27 1951
 Remarks Edwards Pool
Jackson Drlg. - Contr.
 Spudding Date 4-28-51

Drlg. Data Oil well TD 3272
8" @ 211 Heeb. 2639 Br. lime 2757
Lans. 2774 Viola 3164 Simp. 3202
Arb. 3252 TD 3272 DS^I 3204-18
Rec. 30' mud DST 3204-56 Rec. 85' mud
DST 3253-64 open $\frac{1}{2}$ hr. Rec. 2765' oil
5" @ 3272 S/ 150 bo 4 hr. 24/ 3248-58
S/ 150 bo 4 hr. Comp. 688 bopd

J. E. TYRA