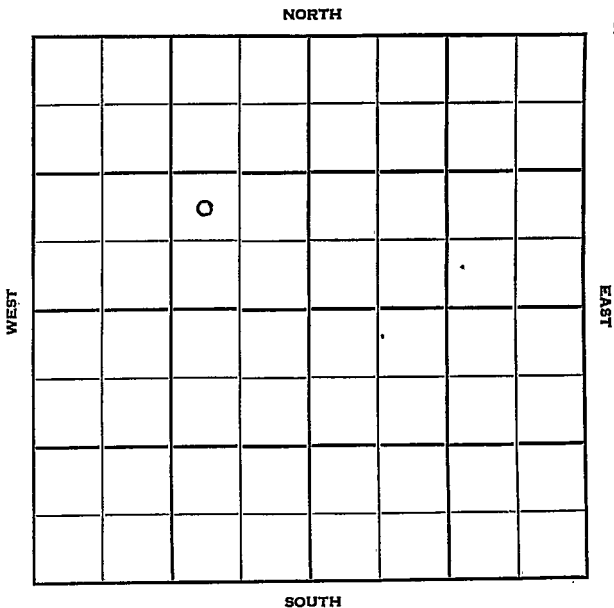


Section 15 Township 17 Range 8 WWell No. #3 "A"
#7 KafkaCompany Westgate-Greenland

Ellsworth **KANSAS**

Sec. 15 Twp. 17 R. 8W ✓

#3 KAFKA "A"

Well No. #7 Kafka Farm

Westgate-Greenland Company

Contractor

Edwards Pool

Ft. from N. Line

990'


Ft. from S. Line

990'

Ft. from E. Line

Ft. from W. Line

NW SE NW

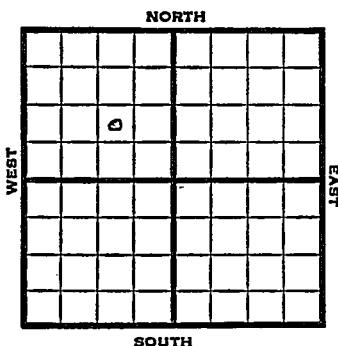

1951

Elev. 1758' REPORT

5/29

Spud 5-25-51

8" @ 198

Drlg. 1510'

8/1

Spud 5-25-51

Oil well TD 3286' 8" @ 198'

DST 3211-21 open 1 hr. rec 150' HO & GCM

Heeb 2676' Br. lime 2796'

Cong. 3209' Arb. 3256'

DST 3258-83 open 1 hr. rec 210' HOCM

5" @ 3283 TD 3286' 115/3257-86

S/3 BO 6 hr.

Comp. 235 BOPD

COMPLETED

J. E. TYRA

Kansas

Map No. _____ Sec. 15 Twp. 17 R. 8WWell No. 3 Kafka "A"_____Westgate-Greenland_____
Company**CORRECTION**_____
Contractor

NW SE NW

SECTION PLAT

	o		

_____Ft. from N. Line_____990 Ft. from S. Line_____990 Ft. from E. Line_____Ft. from W. LineEllsworth County

Location _____

Rig up _____

Drilling and Remarks:

Reported

#7 Kafka

RECORD

Cased _____ in., _____ ft.

Sand _____

Gas _____

Oil _____

Total Depth _____

PRODUCTION

1st 24 hrs. Nat. _____

1st 24 hrs. after shot _____

Gas _____ Cu. Ft.

Dry Hole _____

Abandoned _____

Date

JUN 6 1951

19

J. E. TYRA

Scout

County Ellsworth State Kansas
 Sec. 15 (Blk.) 17 (Sur.) 8W Map No. _____
 Operator Westgate-Greenland
 Well No. 3 Farm Kafka "A"
 Elev. 1758 Location NW SE NW

990 Ft. From S Line NW
990 Ft. From E Line Quarter

Ist. Report

Completion AUG 1 1951

Remarks Edwards Pool

Spudding Date 5-25-51

Drlg. Data Oil well TD 3286

8" @ 198 DST 3211-21 open 1 hr.

Rec. 150' ho & gcm Heeb. 2676

Br. lime 2796 Cong. 3209 Arb. 3256

DST 3258-83 open 1 hr. Rec. 210' hocm

5" @ 3283 TD 3286 115/ 3257-86

S/ 3 bo 6 hr. Comp. 235 bopd

J. E. TYRA