

Ellsworth County

Edwards Pool


FORM 51 IOM 12-46 PETROL

KANSAS

Section 15 Township 17 Range 8W

Well No. 1 Katka

Company Derby Drilg. etal.

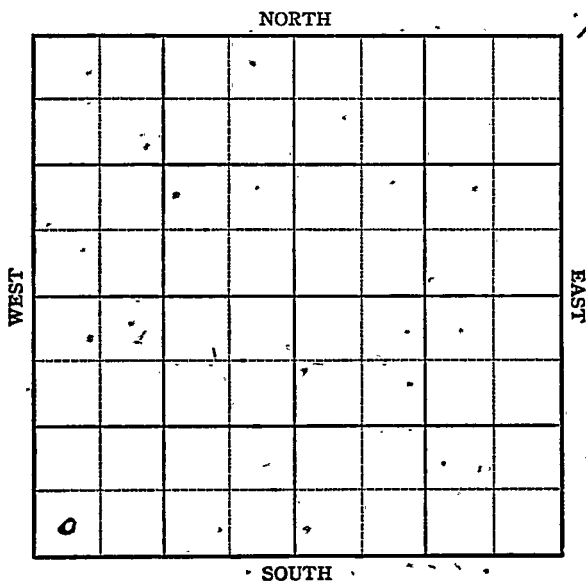

KANSAS

Ellsworth

Sec. 15 Twp. 17 R. 8-W

Well No. #1 Katka Farm


Derby Drlg. etal Company
Edwards Pool

Ft. from N. Line

330 Ft. from S. Line

Ft. from E. Line

330 Ft. from W. Line

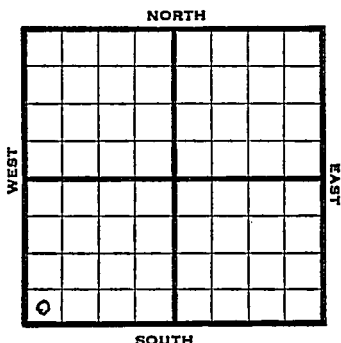

SW/C Elev. 1787'

REPORT

1947

3/5 Location

3/11 8" @ 226'
WOC

3/18 Drlg 2670'

3/25 Arb 3263-67
TD 3267'
5" @ 3264'
RUST

4/2 TD 3267'
2800' oil 2½ hrs.

4/9 " " "

4/15 " " "

4/23 " " "

4/30 Arb 3263'
5" @ 3264
Depth Pot 1433
Grav. 41
TD 3267'

COMPLETED

Kansas KANSAS


Map No. 45 Sec. 15 Twp. 17 R. 8WWell No. 1 KatkaDerby Drlg. etal. Company

FIRST REPORT

Contractor

SW/C

SECTION PLAT

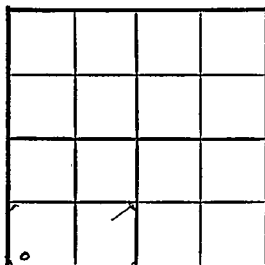 Ft. from N. Line330 Ft. from S. Line Ft. from E. Line330 Ft. from W. LineEllsworth CountyLocation XRig up

Drilling and Remarks:

RECORD

Cased in. ft.Sand Gas Oil Total Depth

PRODUCTION

1st 24 hrs. Nat. 1st 24 hrs. after shot Gas Cu. Ft.Dry Hole Abandoned

Date

MAR 5 1947 19

S. J. LEWIS Scout

KANSAS
Kansas

Edwards Pool

Map No. 45 Sec. 15 Twp. 17 R. 8 SWWell No. 1 KatkaDerby Drlg. etal. Company


COMPLETE

Contractor

EJ, 1982

SW/C

SECTION PLAT

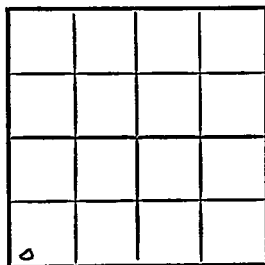 Ft. from N. Line330 Ft. from S. Line Ft. from E. Line330 Ft. from W. LineEllsworth CountyLocation Rig up

Drilling and Remarks:

Core 8263
5" @ 8264
Depth 8263

H1 2/2

RECORD

Cased in., ft.Sand Gas Oil Total Depth 8267

PRODUCTION

1st 24 hrs. Nat. 1st 24 hrs. after shot Gas Cu. Ft.Dry Hole Abandoned

Date

APR 30 1947 19S. J. LEWIS Scout