

Section 15 Township 17 Range 8 WWell No. # 11 Kafka (A)Company Westgate - Greenland

NORTH

6

WEST

			0				

EAST

SOUTH

Ellsworth
17

KANSAS
8W ✓

Sec. 15 Twp. 17 R. 8W

Well No. #4 Kafka (A) Farm

Westgate Greenland Company

Edwards Pool Contractor


 Ft. from N. Line

990' Ft. from S. Line

330' Ft. from E. Line

 Ft. from W. Line

NE SE NW

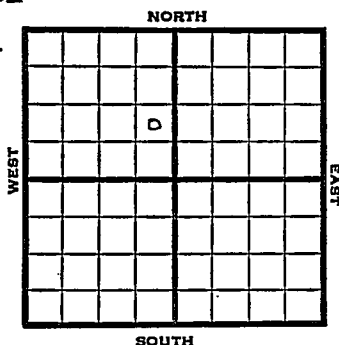

1951

Elev. 1767' REPORT

7/11

Cellar & Pits

9/26

Spud 8-15-51

Oil Well TD 3320

8" @ 214 Br. lime 2805

KC 2824 Arb. 3270-3320

5" @ 3317 TD 3320

1000 A S/ 90 boph 2 hr.

S/ 130 boph

Comp. Echo pot. 1664 bopd

COMPLETED

County **Ellsworth** State **Kansas**

Sec. 16 (Blk.) 17 (Sur.) 8W Map No. (Twp.) (Rge.)

Operator **Westgate Greenland**

Well No. 4 Farm Kafka (A)

Elev. 1767 Location NE SE NW

0

FIRST REPORT

990 Ft. From S Line NW

330 Ft. From E Line Quarter

1st. Report JUL 11 1951

Completion


Remarks

Spudding Date

Drlg. Data Edwards - pool

Cellar and pits

J. E. TYKLA

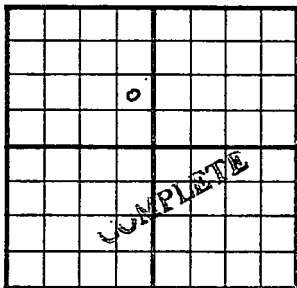County Ellsworth State KansasSec. 15 (Blk. Twp.) 17 (Sur. Rge.) 8W Map No.Operator Westgate-GreenlandWell No. 4 Farm Kafka "A"Elev. 1767 Location NE SE NW990 Ft. From S Line NW330 Ft. From E Line Quarter

1st. Report

Completion SEP 26 1951Remarks Edwards PoolSpudding Date 8-15-51Drlg. Data Oil well TD 33208" @ 214 Br. lime 2805 KC 2824Arb. 3270-3320 5" @ 3317 TD 33201000 A S/ 90 boph 2 hr. S/ 130 bophComp. Echo pot. 1664 bopd

J. E. TYRA