

KANSAS

Ellsworth

Section 15 Township 17 Range 8W

Well No. #2
#1 Kaska

Company Westgate-Greenland

NORTH

4

0							

WEST

EAST

SOUTH

Ellsworth

KANSAS

Sec. 15 Twp. 17 R. 8W ✓

Well No. #1 Kaska Farm

Westgate-Greenland Company

Jackson Drlg. - Contr. Contractor


330' Ft. from N. Line

 Ft. from S. Line

 Ft. from E. Line

330' Ft. from W. Line

NW NW NW

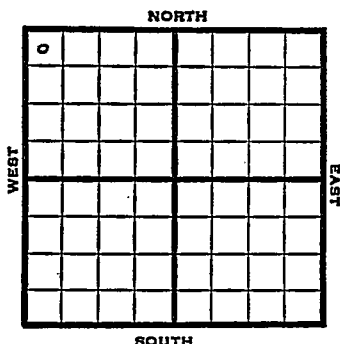

1951

Elev. 1685' REPORT

1/3

RUR

2/21

Spud 1-8-51

Oil well TD 3176

8" @218

Lans. 2740

DST 2765-70 rec. 8" mud

Cong. 3086 Viola 3108 Simp. sh 3120
sand 3126

DST 3124-33 open 1 hr. rec. 16' mud

Arb. 3169-76 TD

5" @3172 S/ 150 bo 2 hr.

Comp. 664 bopd 40 gr.

COMPLETED

County Ellsworth State KansasSec. 15 (Blk. Twp.) 17 (Sur. Rge.) 8W Map No.Operator Westgate-GreenlandWell No. 1 Farm KaskaElev. Location NW NW NW

0							

FIRST REPORT

330 Ft. From N Line NW330 Ft. From W Line Quarter1st. Report JAN 3 1951

Completion

Remarks

Jackson Drlg. - Contr.

Spudding Date

Drlg. Data

RUR

County Ellsworth State Kansas
 Sec. 15 (Blk. 17) (Sur. 8W) (Twp. Map No.)
 Operator Westgate-Greenland
 Well No. 1 Farm Kaska
 Elev. 1685 Location NW NW NW

0							

COMPLETE

330 Ft. From N Line NW
 330 Ft. From W Line Quarter
 Ist. Report
 Completion FEB 21 1951
 Remarks
Jackson Drlg. - Contr.
 Spudding Date 1-8-51

Drlg. Data Oil well TD 3176
8" @ 218 Lans. 2740 DST 2765-70
Rec. 8' mud Cong. 3086 Viola 3108
Simp. sh. 3120 sand 3126 DST 3124-33
open 1 hr. Rec. 16' mud Arb. 3169-76 TD
5" @ 3172 S/ 150 bo 2 hr.
Comp. 664 bopd 40 gr.

J. E. TYRA

Map No. _____ Sec. 15 Twp. 17 R. 8WWell No. (2) KaskaWestgate-Greenland

Company

~~CORRECTION~~
OF WHAT??

Contractor

NW NW NW

SECTION PLAT

330 Ft. from N. Line

_____ Ft. from S. Line

_____ Ft. from E. Line

330 Ft. from W. Line

0			

Ellsworth County

RECORD

Location _____

Cased _____ in., _____ ft.

Rig up _____

Sand _____

Drilling and Remarks:

Gas _____

Oil _____

Completed

Total Depth _____

Feb. 21, 1951

PRODUCTION

#1 Kaska

1st 24 hrs. Nat. _____

1st 24 hrs. after shot _____

Gas _____ Cu. Ft.

Dry Hole _____

Abandoned _____

Date

MAR 21 1951J. E. TYRA

Scout