


Section 16 Township 17 Range 10W

Well No. #1 Frevert

Company Duke & Wood

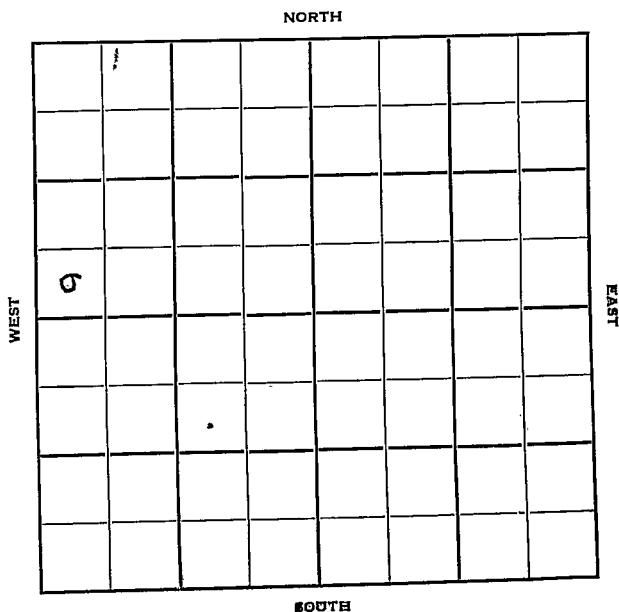

Ellsworth

KANSAS

Sec. 16 Twp. 17 R. 10W

Well No. #1 Frevert Farm

Duke & Wood Company

Dike & Wood Contractor

Wildcat


 Ft. from N. Line

330 Ft. from S. Line

 Ft. from E. Line

330 Ft. from W. Line

SW SW NW

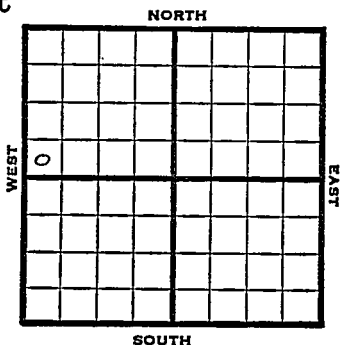

1951

Elev. 1856' REPORT

10/24

Spud 10-21-51
8" @ 197
Anhy 620'
Drlg. 680'

11/28

Spud 10-21-51
D&A TD 3331
8" @ 197
Anhy 620 Heeb. 2873
Br Lime 2983
Lans. 2997
DST 3027-34 opn 45 min.
Rec. 9' mud
DST 3181-99 opn 1 hr
Rec. 110' mud & sw
Cong. 3299 Arb. 3326
DST 3326-31 opn 1 hr
Rec. 70' mud & oil 5" @ 3327
CO to 3331
S/20 goph 3 hr. DD 3331
50A FU 190' fluid 12 hr.
500 A 9 bwph $\frac{1}{2}$ boph 24 hrs.
D&A

ABANDONED

County Ellsworth State Kansas

Sec. 16 (Blk. Twp.) 17 (Sur. Rge.) 10W Map No.

Operator Duke & Wood

Well No. 1 Farm Frevert

Elev. 1856 Location SW SW NW

330 Ft. From S Line NW

330 Ft. From W Line Quarter

1st. Report

Completion NOV 28 1951

Remarks Wildcat

Duke & Wood - Contr.

Spudding Date 10-21-51

ABANDONED

Drlg. Data D & A TD 3331

8" @ 197 Anhy 620 Heeb. 2873

Br. lime 2983 Lans. 2997 DST 3027-34

open 45 min. Rec. 9' mud DST 3181-99

open 1 hr. Rec. 110' mud & sw Cong. 3299

Arb. 3326 DST 3326-31 open 1 hr.

Rec. 70' mud & oil 5" @ 3327 CO to 3331

S/ 20 goph 3 hr. DD-3331 50 A

FU 190' fluid 12 hr. 500 A

9 bwph 1/2 boph 24 hr.

D & A

J. E. TYRA