

KANSAS

Ellsworth

Section 16 Township 17 Range 8W

Well No. 3 Rathbun


Company Cities Service

Edwards
NORTH

16

WEST

EAST

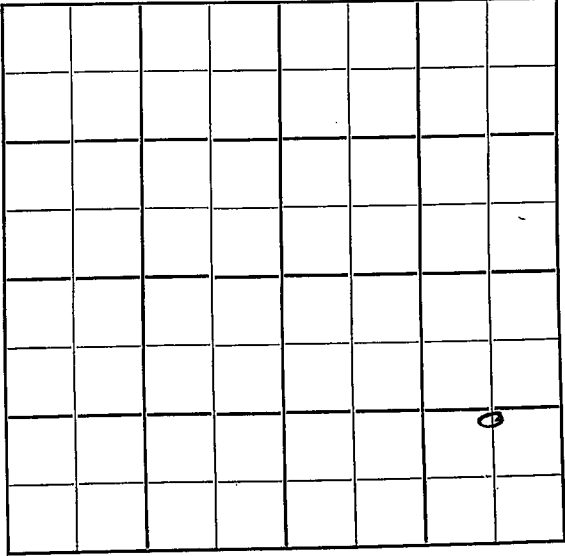

SOUTH

Ellsworth **KANSAS** SW ✓

Sec. 16 Twp. 17 R. 8W

Well No. #3 Ratbun Farm _____

Cities Service Company

Edwards Pool

_____ Ft. from N. Line

1090'


_____ Ft. from S. Line

660'

_____ Ft. from E. Line

_____ Ft. from W. Line

C N L SE SE

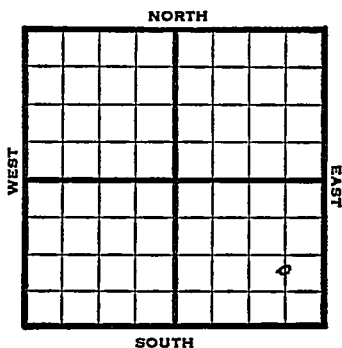

1949 Elev. 1773' REPORT

6/29 Location.

7/6 8" @ 313'

Drlg. 870'

7/12 Arb. 3208-10'

TD 3210'

5" @ 3209'

7/20 TD 3231'

500 acid

Pump 24 bbls oil \neq 1 W 24 hrs.

7/27 Simp 3182'

Arb 3208'

Acid 1500

5" @ 3209'

Pump 38 oil & 5 W Pot.

Gr. 44

TD 3231

COMPLETED

Map No. _____ Sec. 16 Twp. 17 R. 8W

Well No. 3 Rathbun

Cities Service

Company

Contractor

C N L SE SE

**FIRST REPORT
 SECTION PLAT**

_____ Ft. from N. Line

1090 Ft. from S. Line

660 Ft. from E. Line

_____ Ft. from W. Line

			e

Ellsworth County

Location X

Rig up _____

Drilling and Remarks:

RECORD

- Cased _____ in., _____ ft.

Sand _____

Gas _____

Oil _____

Total Depth _____

PRODUCTION

* 1st 24 hrs. Nat. _____

1st 24 hrs. after shot _____

Gas 61 _____ Cu. Ft.

Dry Hole _____

Abandoned _____

Date

JUN 29 1949 19

S. J. LEWIS

Scout

Edwards Pool

Map No. K45 Sec. 16 Twp. 17 R. 8W

Well No. 3 Rathbun

Cities Service Company

COMPLETE

Contractor

C N L SE SE

E 41773
SECTION PLAT

_____ Ft. from N. Line

1090 Ft. from S. Line

660 Ft. from E. Line

_____ Ft. from W. Line

			o

Ellsworth County

Location _____

Rig up _____

Drilling and Remarks:

Imp. 3182.
Ch 73205.
5" C 8208
1500 acw
Imp 85 oil + 5 1/2"
44 2 1/2"

RECORD

Cased _____ in., _____ ft.

Sand _____

Gas _____

Oil _____

Total Depth 3231

PRODUCTION.

1st 24 hrs. Nat. _____

1st 24 hrs. after shot _____

Gas _____ Cu. Ft.

Dry Hole _____

Abandoned _____

Date

JUL 27 1949

S. J. LEWIS

Scout