

Sec. 16 Twp. 17 R. 8-W

Well No. #4 Rathbun Farm

Cities Service Company

Geneseo


_____ Ft. from N. Line

330 Ft. from S. Line

1347 Ft. from E. Line

_____ Ft. from W. Line

G S L SE

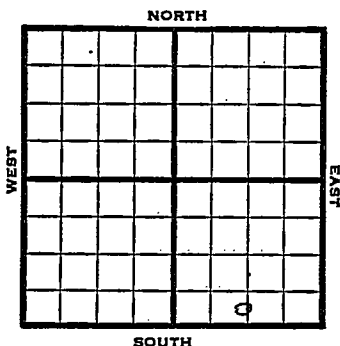

1949

Elev. 1740' REPORT

10/12

Location

10/19

8" @ 300'
Drlg - 2190'

10/26

Arbuckle 3159'
TD 3161'
5" @ 3160'

11/1

TD 3188'
Pump 68 bbls oil SW 15 hrs.

11/9

TD 3188'
Arb. 3159'
5" @ 3160'
Pump 72 Oil Pot
41° Gr.
Comp

COMPLETED

Map No. _____ Sec. 16 Twp. 17 R. 8W

Well No. 4 Rathbun

Cities Service

Company

Contractor

C S L SE

FIRST SECTION REPORT

_____ Ft. from N. Line

330 Ft. from S. Line

1347 Ft. from E. Line

_____ Ft. from W. Line

Ellsworth County

Location X

Rig up

Drilling and Remarks:

RECORD

Cased _____ in., _____ ft.

Sand _____

Gas _____

Oil _____

Total Depth _____

PRODUCTION

1st 24 hrs. Nat. _____

1st 24 hrs. after shot _____

Gas _____ Cu. Ft.

Dry Hole _____

Abandoned _____

Date

OCT 12 1949

S. J. LEWIS

Scout

Kansas

Geneseo Pool

Map No. _____ Sec. 16 Twp. 17 R. 8WWell No. 4 Rathbun

_____ Cities Service _____ Company

COMPLETE

Contractor

C S L SE

E. 1740
SECTION PLAT

_____ Ft. from N. Line

330 Ft. from S. Line1347 Ft. from E. Line

_____ Ft. from W. Line

Ellsworth County

Location _____

Rig up _____

Drilling and Remarks:

*Art 3159**5" Q2160**Pump 72 oil**410***RECORD**

Cased _____ in., _____ ft.

Sand _____

Gas _____

Oil _____

Total Depth 3159**PRODUCTION**

1st 24 hrs. Nat. _____

1st 24 hrs. after shot _____

Gas _____ Cu. Ft.

Dry Hole _____

Abandoned _____

Date

NOV 9 1949

19

S. J. LEWIS

Scout