Ellsworth

FORM 51 5M 6-46 PETROL

KANSAS


Section 16 Township 17 Range 8W

Well No. #1 ~~2~~ Rathbun - "A"

Company Phil-Han

Edwards.

14

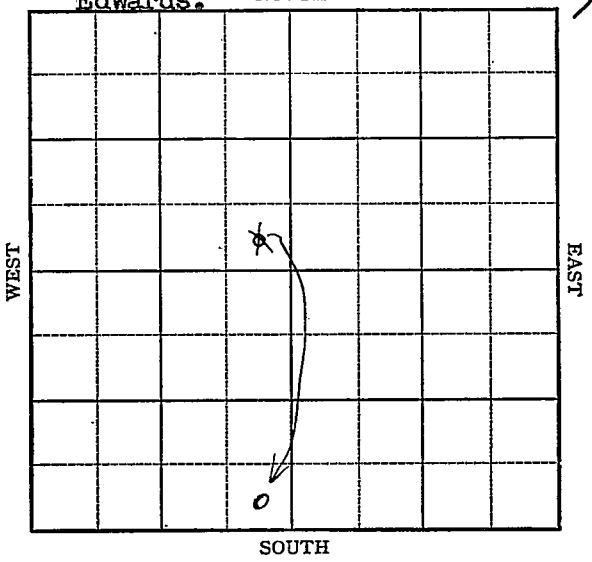

FORM 252-A
5M 12-46 PETROL

KANSAS

Ellsworth county

Sec. 16 Twp. 17 R. 8W

Well No. #1 Rathbun "A" Farm

Phil-Han Company

Edwards Pool


Ft. from N. Line

330 Ft. from S. Line

330 Ft. from E. Line

Ft. from W. Line

SE ~~NW~~ SW

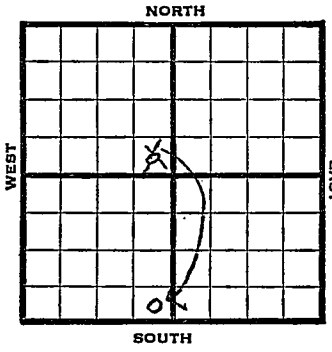

	REPORT
1947	Elev. 1782
5/7	Surface hole
5/13	8" @ 258' Drlg. 2840'
5/21	Cong 3206 Viola 3252 TD 3293'
	ABANDONED

Form 26 200 Bks. 10-46 Petrol

Kansas

Edwards Pool

Map No. K45 Sec. 16 Twp. 17 R. 8W

Well No. 2 Rathbun


Phil-Han Company

FIRST REPORT

Contractor

SE NW

SECTION PLAT

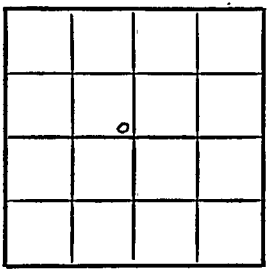

____ Ft. from N. Line

330 Ft. from S. Line

330 Ft. from E. Line

____ Ft. from W. Line

Ellsworth County

Location

Rig up

Drilling and Remarks:

surface hole

RECORD

Cased ___ in., ___ ft.

Sand

Gas

Oil

Total Depth

PRODUCTION

1st 24 hrs. Nat.

1st 24 hrs. after shot

Gas Cu. Ft.

Dry Hole

Abandoned

Date

MAY 7 1947 19

S. J. LEWIS Scout

Form 26 200 Bks. 10-46 Petrol
Kansas

Edwards Pool

Map No. K45 Sec. 16 Twp. 17 R. 8W


Well No. 1 Rathbun "A"

Phil-Han Company

CORRECTION Contractor

SE SW

SECTION PLAT

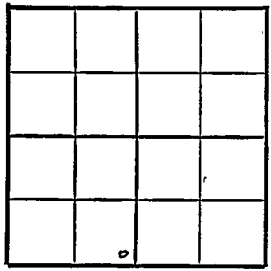

____ Ft. from N. Line

330 Ft. from S. Line

330 Ft. from E. Line

____ Ft. from W. Line

Ellsworth County

Location

Rig up

Drilling and Remarks:

Reported
#2 Rathbun
SE NW

RECORD

Cased ____ in., ____ ft.

Sand

Gas

Oil

Total Depth

PRODUCTION

1st 24 hrs. Nat.

1st 24 hrs. after shot

Gas ____ Cu. Ft.

Dry Hole

Abandoned

Date

MAY 14 1947 19 S. J. LEWIS Scout

Form 26 200 Bks. 10-46 Petrol

Edwards Pool

Kansas

Map No. K-45 Sec. 16 Twp. 17 R. 8W

Well No. 1 Rathbun "A"


Phil-Han Company

ABANDONED Contractor

SE SW

E 1,782

SECTION PLAT

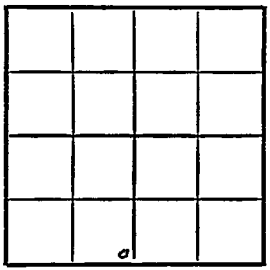

Ft. from N. Line

330 Ft. from S. Line

330 Ft. from E. Line

Ft. from W. Line

Ellsworth County

Location

Rig up

Drilling and Remarks:

Comp 8206

Viola 3252

RECORD

Cased in., ft.

Sand

Gas

Oil

Total Depth 3288 2

PRODUCTION

1st 24 hrs. Nat.

1st 24 hrs. after shot

Gas Cu. Ft.

Dry Hole

Abandoned

Date

MAY 2 1 1947 19 S. J. LEWIS Scout