


Section 16 Township 17 Range 8W

Well No. #3 Rathbun (A)

Company Westgate Greenland

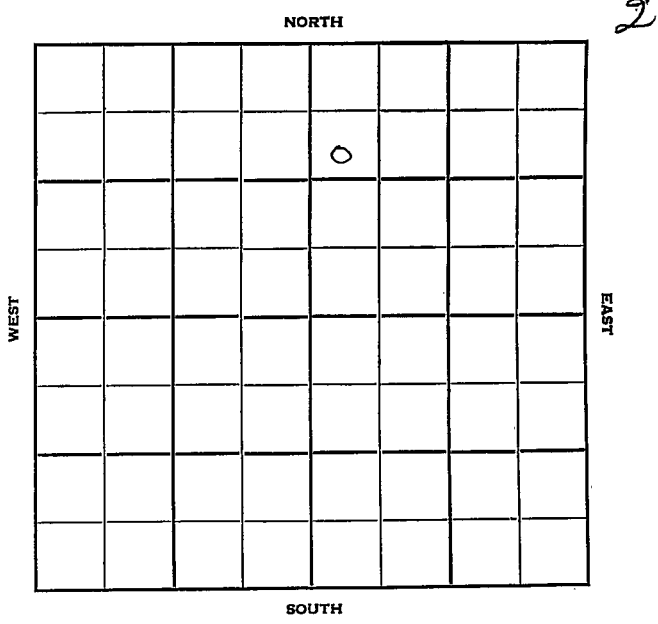

Sec. 16 Twp. 17 R. 8W

Well No. #3 Rathbun "A" Farm

Westgate Greenland Company

Jackson - Contr. Contractor

Edwards Pool


990' Ft. from N. Line

_____ Ft. from S. Line

_____ Ft. from E. Line

330' Ft. from W. Line

SW NW NE

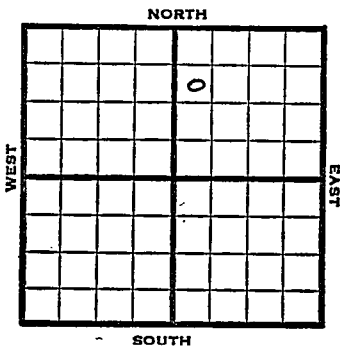

1951 Elev. 1717' REPORT

9/12 Spud 9-10-51
8" @ 215
WOC

11/21 Spud 9-10-51
Oil Well TD 3268
8" @ 215
Heeb. 2648 Br Lime 2767
Lans. 2790 BKG 3112
Simp 3144
DST 3146-54 opn 1/2 hr. Rec. 5' mud
Arb. 3182
DST 3232-42 opn 1 hr
Rec. 1260' oil TD 3268
5" @ 3267 CO to 3250
70/3236-49 FU 400' oil 1 1/2 hr.
1000 A No inc.
Comp. 446 bopd

COMPLETED

