

KANSAS

Section 16 Township 17

Range 8 W

Well No. # 1 Rothburn (B)

(Rathburn)

Company Westgate Greenland Oil

NORTH

3

			0				

WEST

EAST

SOUTH

Ellsworth

KANSAS

Sec. 16 Twp. 17 R. 8 W ✓

Well No. # 1 Rothburn (B) Farm

Westgate Greenland Oil Company

Jackson Contractor

**Edwards Pool**


330 Ft. from N. Line

\_\_\_\_\_ Ft. from S. Line

330 Ft. from E. Line

\_\_\_\_\_ Ft. from W. Line

NE NE NW

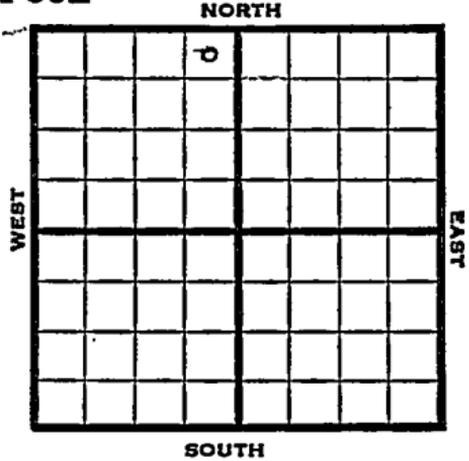

1951

Elev. 1710' REPORT

6/27

8" @ 223'  
Drlg. 1550'

8/15

Oil well TD 3237' 8" @ 223  
 Viola 3128' Lans. 2789' Cong. 3102  
 Simp. 3177' Arb. 3214'  
 DST 3214-35 open 1 hr. rec 1715' oil  
 1235' gas TD 3237' 5" @ 3236'  
 72/3215-33 S/12 BOPH S/72 BO  
 6 hr.  
 Comp. 340 BOPD

**COMPLETED**



