


Section 16 Township 17 Range 8 W

Well No. # 1 Rathbun

Company Westgate-Greenland

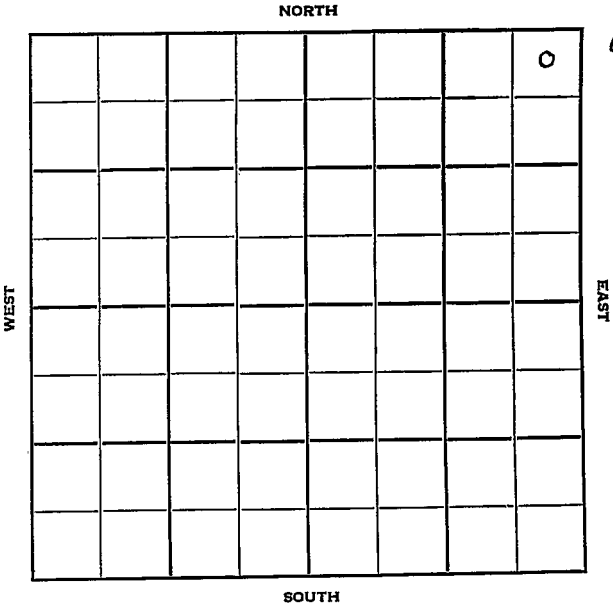

Ellsworth

KANSAS

Sec. 16 Twp. 17 R. 8 W ✓

Well No. # 1 Rathbun Farm

Westgate-Greenland Company

Jackson Drlg. Contractor

Edwards Pool


330 Ft. from N. Line

\_\_\_\_\_ Ft. from S. Line

330 Ft. from E. Line

\_\_\_\_\_ Ft. from W. Line

NE NE NE

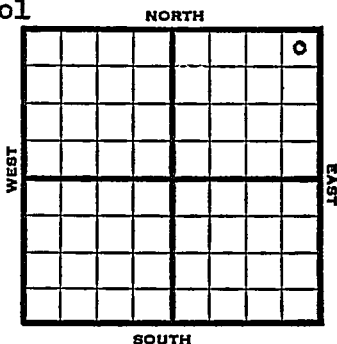

1951 Elev. 1677' REPORT

3/28 Pits  
 5/23 Oil well TD 3214' 10" @ 222  
 Heeb 2600' Br. lime 2719' Lans 2738'  
 BKC 3097' Cong 3099' Sand 3149'  
 DST 3159-66 open 1 hr. rec 460' water  
 Arb. 3203'  
 DST 3204-10 open 1 hr. rec 120' gassy  
 oil, 225' HOCM TD 3212' 7" @ 3200'  
 S/ 4 BOPH DD 3214' 1000 A  
 Comp. 278 BOPD

**COMPLETED**



