


Section 16 Township 17 **KANSAS** 8W
Range

Well No. #5 Rathbun

Company Cities Service Oil

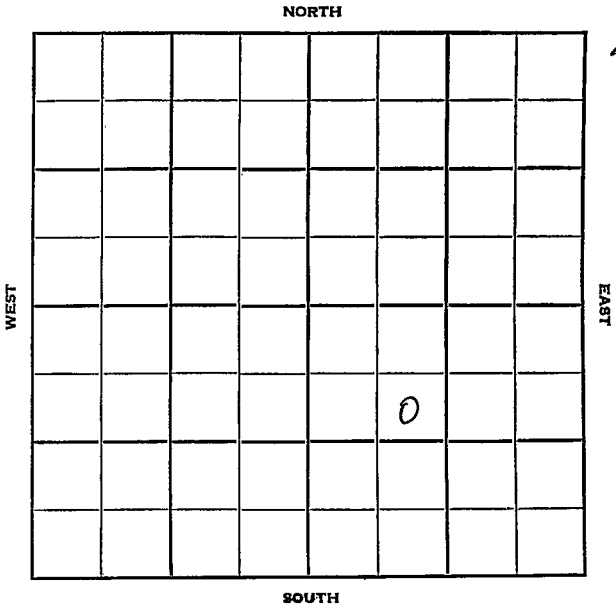

Ellsworth

Sec. 16 Twp. 17 R. 8W **KANSAS**

Well No. #5 Rathbun Farm

Cities Service Oil Company

Edwards Contractor


720' Ft. from N. Line

..... Ft. from S. Line

..... Ft. from E. Line

885' Ft. from W. Line

SE NW SE

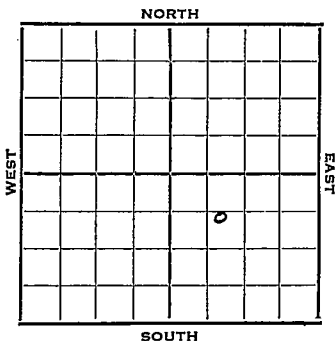

1951 Elev. 1754' REPORT

11/28 Spud 11-22-51
8" @ 315
Drlg. 1820'

1952
1/2 Spud 11-22-51
Oil Well TD 3210
8" @ 315
KC 2808 Simp. 3182
Arb. 3186-90
5" @ 3187 TD 3210
FU 1730' oil 7 hr.
P. 290 BOPD
Comp. 274 BOPD

COMPLETED

