


KANSAS

Section 16 Township 17 Range 8W

Well No. #1 Rathburg "A" (*Rathbun*)

Company Westgate-Greenland

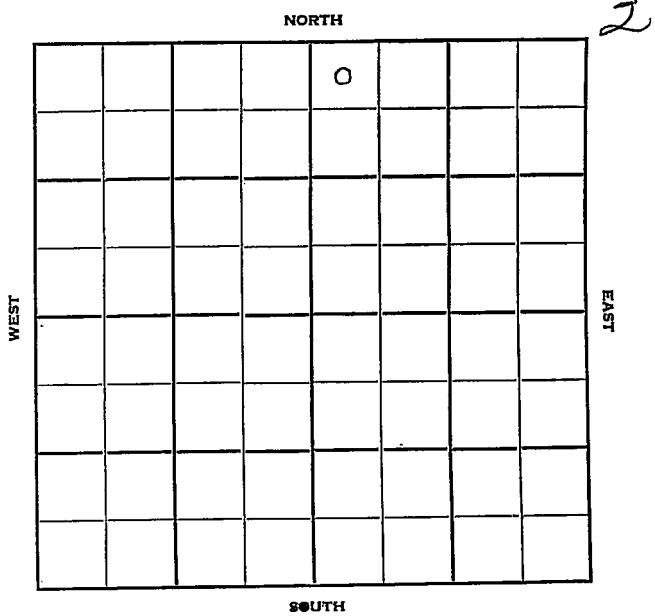

Ellsworth

KANSAS

Sec. 16 Twp. 17 R. 8W ✓

Well No. #1 Rathburg "A" Farm

Westgate-Greenland Company

Contractor


330' Ft. from N. Line

Ft. from S. Line

Ft. from E. Line

330' Ft. from W. Line

NW NW NE

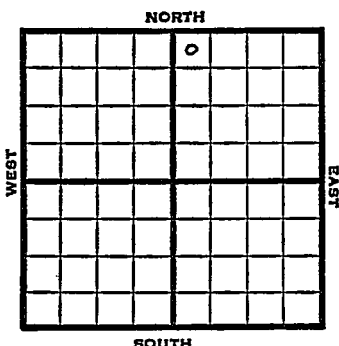

1951

Elev. 1721' REPORT

5/9

Location

8/15

Spud 6-8-51

Oil well TD 3247' 8" @ 216'

Heeb 2649' Br. lime 2768'

Lans. 2788'

DST 2817-26 open $\frac{1}{2}$ hr. rec 10' mud
& SSO Arb. 3172'

DST 3175-90 open 1 hr. rec 200' gas,
150' O & GCM TD 3241' 5" @ 3241'

DD 3246' S/15 BOPH DD 3247

S/135 BO 9 hr.

Comp. 448 BOPD

COMPLETED

County Ellsworth State KansasSec. 16 (Blk. Twp.) 17 (Sur. Rge.) 8W Map No.Operator Westgate-GreenlandWell No. 1 Farm Rathburg "A"Elev. Location NW NW NE

1				0			

330 Ft. From N Line NE330 Ft. From W Line Quarter1st. Report MAY 9 1951

Completion

Remarks

Spudding Date

Drilg. Data

Location

J. E. TYRA



J. E. TYRA