

Section 16 Township 17 Range 8 W

Well No. # 2 Rathbun (A)

Company Westgate-Greenland

NORTH

2

					0		

WEST

EAST

SOUTH

Ellsworth

KANSAS

Sec. 16 Twp. 17 R. 8W

Well No. #2 Rathbun (A) Farm

Westgate Greenland Company

Jackson Contr. Contractor

Edwards Pool


330' Ft. from N. Line

_____ Ft. from S. Line

_____ Ft. from E. Line

990' Ft. from W. Line

NE NW NE

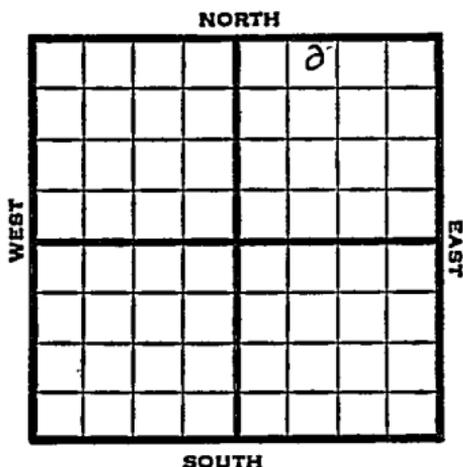

1951

Elev. 1713' REPORT

7/11

Spud 7-5-51
10" @ 216
Drlg. 1890'

7/25

Spud 7-5-51
D & A TD 3308' 10" @ 216'
Heeb 2652' Br. lime 2773' Lans. 2793'
Cong. 3150'
DST 3235-43 open 1 hr. rec 25' mud
Arb. 3209-3308' D & A

ABANDONED

County **Ellsworth** State **Kansas**

Sec. **16** (Blk. Twp.) **17** (Sur. Rge.) **8W** Map No.

Operator **Westgate Greenland**

Well No. **2** Farm **Rathbun (A)**

Elev. Location **NE NW NE**

			0		

330 Ft. From **N** Line **NE**

990 Ft. From **W** Line Quarter

1st. Report **JUL 11 1951**

Completion

Remarks

Jackson - Contr.

Spudding Date **7-5-51**

Drig. Data **Edwards - pool**

10" @ 216' Drig. 1890

J. E. TYRA

County Ellsworth State Kansas

Sec. 16 (Blk. 17 (Sur. 8W (Twp.) Rge.) Map No.

Operator Westgate-Greenland

Well No. 2 Farm Rathbun "A"

Elev. 1713 Location NE NW NE

330 Ft. From N Line NE
990 Ft. From W Line " Quarter

Ist. Report

Completion JUL 25 1951

Remarks Edwards Pool
Jackson - Contr.

Spudding Date 7-5-51

ABANDONED

Drlg. Data D & A TD 3308

10" @ 216' Heeb. 2652 Br. line 2773

Lans. 2793 Cong. 3150 DST 3235-43

open 1 hr. Rec. 25' mud Arb. 3209-3308

D & A

J. E. TYRA