


Section 16 Township 17 Range 8W

Well No. #3 Rathbun (B)

Company Westgate Greenland

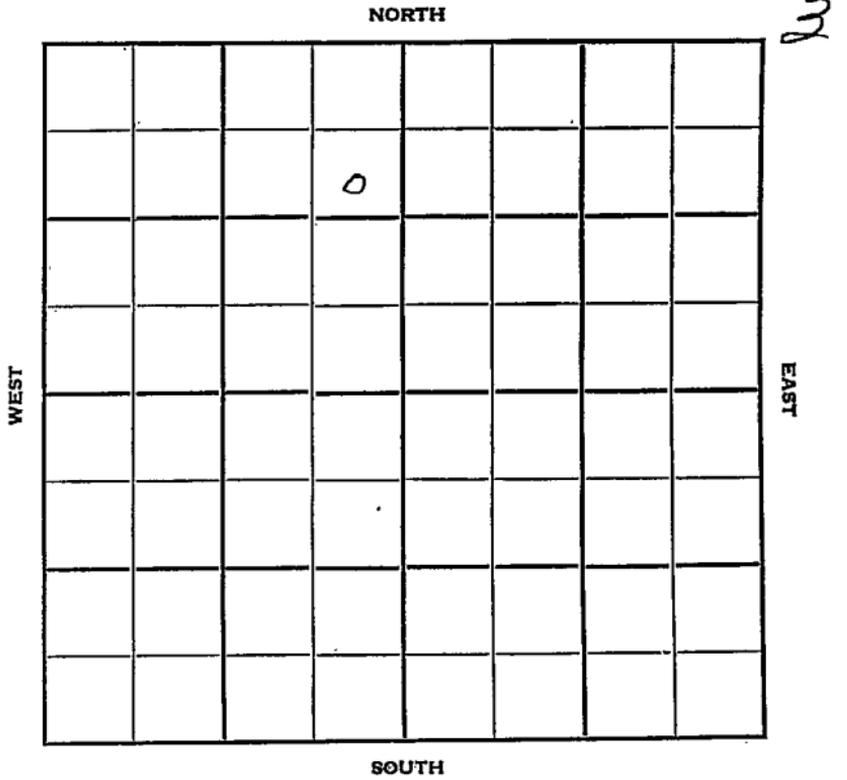

Ellsworth

KANSAS

Sec. 16 Twp. 17 R. 8 W

Well No. # 3 Rathbun (B) Farm

Westgate-Greenland Company

Jackson Contractor

Edwards


990 Ft. from N. Line

\_\_\_\_\_ Ft. from S. Line

330 Ft. from E. Line

\_\_\_\_\_ Ft. from W. Line

SE NE NW

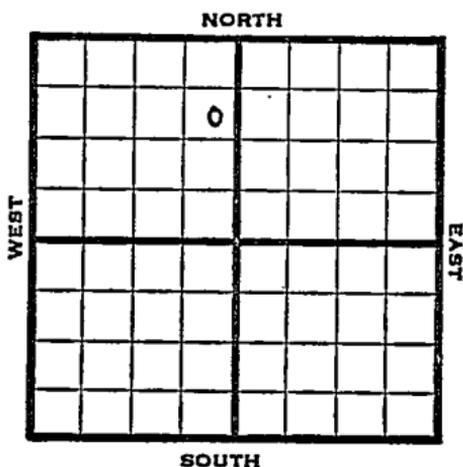

1951

Elev. 1743' REPORT

10/10

Spud 10-4-51  
10" @ 200  
Drlg. 1560'

11/28

Spud 10-4-51  
Oil Well TD 3282  
10" @ 200  
Heeb. 2676  
Br Lime 2803  
Lans. 2825  
BKC 3141  
Simp. 3169  
Arb. 3203  
DST 3232-68 opn 1 hr  
Rec. 2280' gas 1685' oil TD 3282  
5" @ 3281 72/3234-52 S/60 bo 4 hr.  
Comp. 611 bopd

**COMPLETED**



County Ellsworth State Kansas

Sec. 16 (Blk. Twp.) 17 (Sur. Rge.) 8W Map No.

Operator Westgate-Greenland

Well No. 3 Farm Rathbun "B"

Elev. 1743 Location SE NE NW


990 Ft. From N Line NW

330 Ft. From E Line Quarter

Ist. Report

Completion NOV 28 1951

Remarks Edwards Pool

Jackson Drlg. - Contr.

Spudding Date 10-4-51

**COMPLETE**

Drlg. Data Oil well TD 3282

10" @ 200 Heeb. 2676 Br. line 2803

Lans. 2825 B KC 3141 Simp. 3169

Arb. 3203 DST 3232-68 open 1 hr.

Rec. 2280' gas 1685' oil TD 3282

5" @ 3281 72/ 3234-52 S/ 60 bo 4 hr.

Comp. 611 bopd

J. E. TYRA