

KANSAS

Ellsworth

O. W. D. D


Section 16 Township 17 Range 8WWell No. 1⁵ Rathburn (A)Company Westgate - Greenland
J. E. Dozier et al

NORTH

WEST

EAST

SOUTH

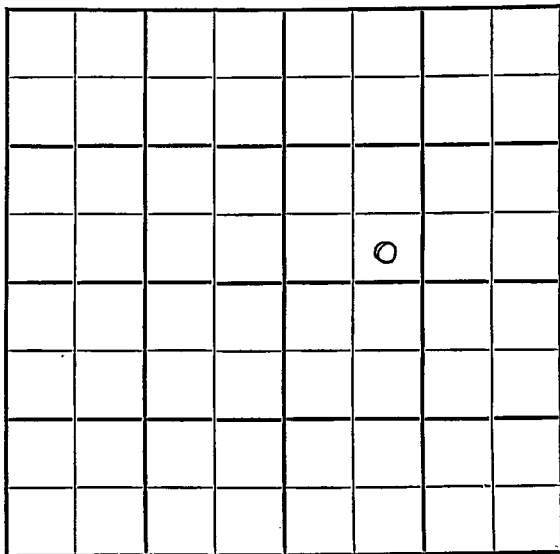

Sec. 16 Twp. 17 R. 1 8WWell No. #7 Bathburn (A) Farm
Westgate-Greenland
J. C. Dozier et al Company

Wildcat


Ft. from N. Line

330 Ft. from S. Line

Ft. from E. Line

990 Ft. from W. Line

NORTH

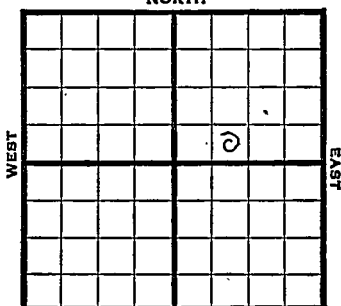

SOUTH

SE SW NE

1948

Elev. 1766' REPORT

4/28

8" @ 215'

Drlg. 2439'

5/5

Viola 3199'

Simp. 3236'

Arbuckle 3274'

TD 3285'

ABANDONED

1952

4/16

Lans. 2842 V 3199 Simp 3236

Arb. 3274 OTD 3285 was D&A

DST 3277 $\frac{1}{2}$ -84 1 hr. 60' O&GCM

1000# DST 3273-91 1 hr. 40' free

oil 90' M&GCM 260' wtr 1000#

RTD 3323 5" @ 3322?

4/23

4/30

CO 3290 45/ 3273-88 SO 1000 A

S/ 48 BO in 8 hrs. 5% wtr. POP

5/7

NR

5/14

"

5/21

NR

5/28

Oil well TD 3323' Lans. 2842'

Viola 3199' Simp. 3236' Arb. 3274'

OTD 3285' DST 3277-84 open 1 hr,

rec 60' O & GCM

DST 3273-91 open 1 hr. rec 40' free

oil, 90' M & GCM, 260' water.

TD 3323' 5" @ 3322' CO to 3290'

45/3273-88 1000 A S/48 BO 8 hr.


5% water Comp. 190 BOPD 42% water.

COMPLETED

Map No. _____ Sec. 16 Twp. 17 R. 8WWell No. 1 Rathburn_____J. C. Dozier et al._____Company_____FIRST REPORT_____Contractor

SE SW NE

SECTION PLAT

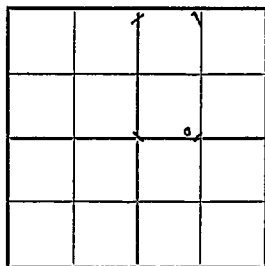_____Ft. from N. Line330 _____Ft. from S. Line_____Ft. from E. Line990 _____Ft. from W. Line_____Ellsworth County_____

Location _____

Rig up _____

Drilling and Remarks:

8" @ 215drlg. 2439

RECORD

Cased _____ in., _____ ft.

Sand _____

Gas _____

Oil _____

Total Depth _____

PRODUCTION

1st 24 hrs. Nat. _____

1st 24 hrs. after shot _____

Gas _____ Cu. Ft.

Dry Hole _____

Abandoned _____

Date

APR 28 1948 19 _____ S. J. LEWIS Scout

Map No. 45 Sec. 16 Twp. 17 R. 8W

Well No. 1 Rathburn

J. C. DOzier et al. Company

ABANDONED

Contractor

SE SW NE

E11766
SECTION PLAT

 Ft. from N. Line

330 Ft. from S. Line

 Ft. from E. Line

990 Ft. from W. Line

Ellsworth County

Location

Rig up

Drilling and Remarks:

Vista 3189
Time 2236
Per 3274

RECORD

Cased in., ft.

Sand

Gas

Oil

Total Depth 2280

PRODUCTION

1st 24 hrs. Nat.

1st 24 hrs. after shot

Gas Cu. Ft.

Dry Hole

Abandoned


Date

MAY 5 1948 19 S. J. LEWIS Scout

J. G. McGEHEE

O. W. D. D

County Ellsworth State Kansas
 Sec. 16 (Blk. 17) (Sur. 8W) (Twp.) (Rge.) Map No.
 Operator Westgate-Greenland (was Dozier)
 Well No. 5 Farm Rathburn "A"
 Elev. 1756 Location SE SW NE

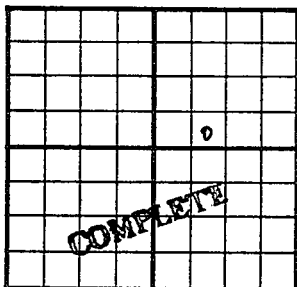

330 Ft. From S Line NE

990 Ft. From W Line Quarter

1st. Report

Completion MAY 28 1952

Remarks

O. W. D. D

Spudding Date

Drlg. Data Oil well TD 3323

Lans. 2842 Viola 3199 Simp. 3236

Arb. 3274 OTD 3285 DST 3277-84

open 1 hr. Rec. 60' o & gcm DST 3273-91

open 1 hr. Rec. 40' free oil 90' m & gcm

260' water TD 3323 5" @ 3322

CO to 3290 45/ 3273-88 1000 A

S/ 48 bo 8 hr. 5% water

Comp. 190 bopd 42% water

J. G. McGEHEE