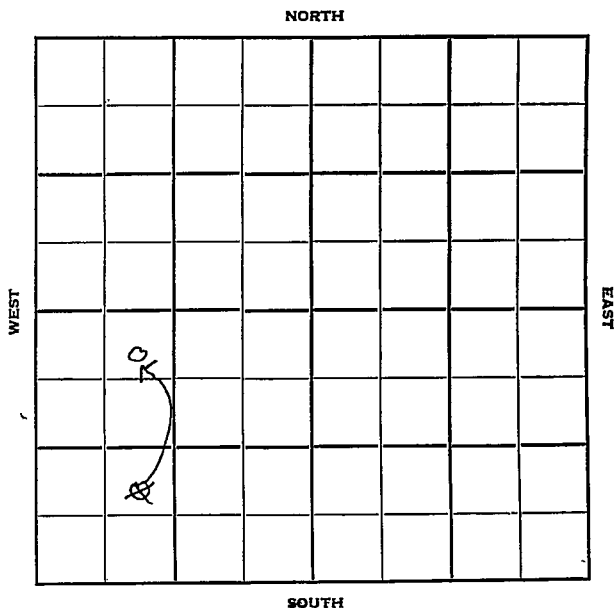


Section 17 Township 17 Range 10WWell No. #1 AldenCompany Imperial Pet. et al

Ellsworth

Sec. 17 Twp. 17 R. 10W

Well No. #1 Alden Farm

Imperial Pet. et al Company

Contractor

330 Ft. from N. Line


990 Ft. from S. Line

Ft. from E. Line


990 Ft. from W. Line

NE SW SW

NE NW SW

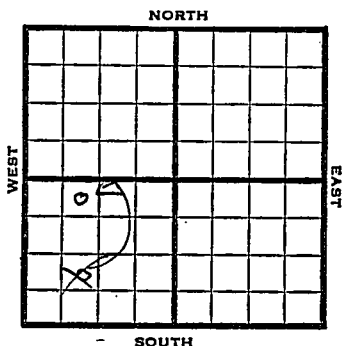

1952	Elev. 1835'	REPORT
2/6	Spud 1-31-52 8" @ 222' Anhy 620-50 Drlg. 2600'	
2/13	Spud 1-31-52 8" @ 222' Anhy 620-50 Br. Li 2968 DST 3026-58 open $\frac{1}{2}$ hr. rec. 4' mud Cong. 3273 DST 3312-18 open 1 hr. rec. 12' mud DST 3318-26 open 1 hr. rec. 12' mud TD 3346' D&A	Heeb. 2858 Lans. 2988 Arb. 3311
ABANDONED		

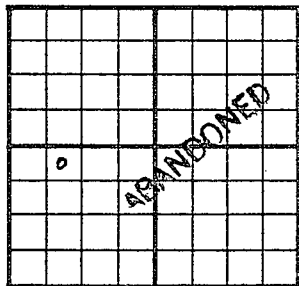County Ellsworth State KansasSec. 17 (Blk.
Twp.) 17 (Sur.
Rge.) 10W Map No.Operator Imperial Pet. etal.Well No. 1 Farm AldenElev. 1835 corr. Location NE NW SW330 Ft. From N Line SW990 Ft. From W Line Quarter

1st. Report

Completion FEB 13 1952

Remarks

Spudding Date 1-31-52Drig. Data D & A TD 33468" @ 222 Anhy 620-50 Heeb. 2858Br. lime 2968 Lans. 2988 DST 3026-58open $\frac{1}{2}$ hr. Rec. 4' mud Cong. 3273Arb. 3311 DST 3312-18 open 1 hr.Rec. 12' mud DST 3318-26 open 1 hr.Rec. 12' mud TD 3346D & A

J. G. McGEHEE

County **Ellsworth** State **Kansas**Sec. **17** (Blk.) **17** (Sur.) **10W** Map No.Operator **Imperial Pet. etal.**Well No. **1** Farm **Alden**Elev. **1827** Location **NE SW SW**

FIRST REPORT

See correction

990 Ft. From **S** Line **SW**990 Ft. From **W** Line Quarter1st. Report **FEB 6 1952**

Completion

Remarks

Spudding Date **1-31-52**

Drlg. Data

8" @ 222 Anhy 620-50 Drlg. 2600**J. G. MCGEE**

Map No. _____ Sec. 17 Twp. 17 R. 10W

Well No. 1 Alden

Imperial Pet. Company

Contractor

NE NW SW


SECTION PLAT

330 Ft. from N. Line

_____ Ft. from S. Line

_____ Ft. from E. Line

990 Ft. from W. Line

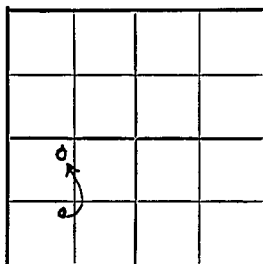

Ellsworth

Location _____

Rig up _____

Drilling and Remarks:

Reported

NE SW SW

RECORD

Cased _____ in., _____ ft.

Sand _____

Gas _____

Oil _____

Total Depth _____

PRODUCTION

1st 24 hrs. Nat. _____

1st 24 hrs. after shot _____

Gas _____ Cu. Ft.

Dry Hole _____

Abandoned _____

Date

FEB 14 1952

19

J. G. McGEHEE

Scout