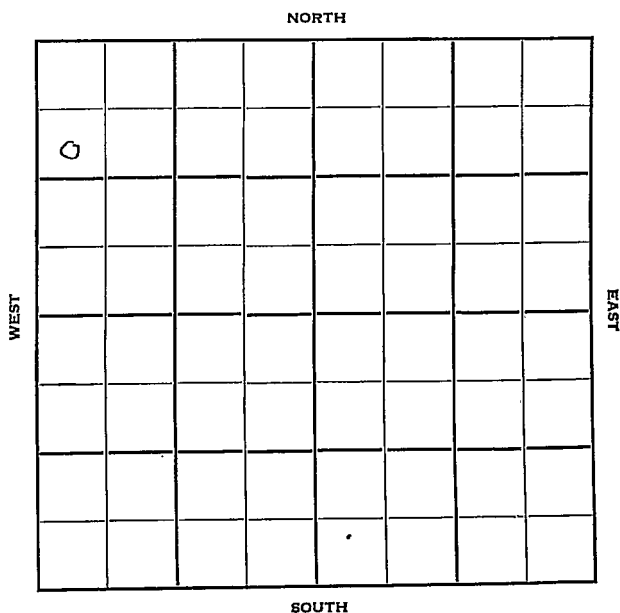


Section 17 Township 17 Range 10WWell No. #1 PetermanCompany B&R Drilling

Ellsworth
17

KANSAS

10W

Sec. 17 Twp. 17 R. 10W

Well No. #1 Peterman Farm

B & R Drlg. Company

B & R Drlg. -Contr. Contractor

Bloomer Pool


990' Ft. from N. Line

Ft. from S. Line

Ft. from E. Line

330' Ft. from W. Line

SW NW NW

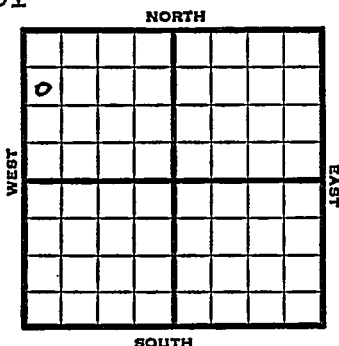

1951 Elev. 1843' REPORT

9/19 Spud 9-13-51
8" @ 320
Drlg. 2270'

11/7 Spud 9-13-51
Oil Well TD 3318
8" @ 320
Heeb. 2860
Ians. 2989
5" @ 3296 TD 3302 2000 A
S/ 2 BOPH DD 3318
S/ 4 BOPH
Comp. 40 BOPD

Br. 1m. 2973
Arb. 3294-97

COMPLETED

County Ellsworth State Kansas
 Sec. 17 (Blk. 17) (Sur. 10W) Map No.

Operator B & R Drilling
 Well No. 1 Farm Peterman

Elev. Location SW NW NW

0							

990 Ft. From N Line NW

330 Ft. From W Line Quarter

1st. Report SEP 19 1951

Completion

Remarks

B & R Drlg. - Contr.

Spudding Date 9-13-51

Drlg. Data Bloomer - pool

8" @ 320 Drlg. 2270

J. E. TYRA

County Ellsworth State Kansas
 Sec. 17 (Blk.) 17 (Sur.) 10W Map No.
 Operator B & R Drlg.
 Well No. 1 Farm Peterman
 Elev. 1843 Location SW NW NW

0							

990 Ft. From N Line NW
330 Ft. From W Line Quarter
 Ist. Report NOV 7 1951
 Completion
 Remarks Bloomer Pool
B & R Drlg. - Contr.
 Spudding Date 9-13-51

Drlg. Data Oil well TD 3318

8" @ 320 Heeb. 2860 Br. line 2973

Lans. 2989 Arb. 3294-97 5" @ 3296

TD 3302 2000 A S/ 2 boph DD 3318

S/ 4. boph Comp. 40 boph

J. E. TYRA