

Section 17 Township 17 Range 1W

Well No.: #1 H. Anderson

Company Continental

NORTH

2

				*			
0							

WEST

EAST

SOUTH

McPherson

KANSAS

Sec. 17 Twp. -17 R. 4W

Well No. #1 H. Anderson Farm

Continental

Company

Anschultz

Contractor

Wildcat

Ft. from N. Line

330


Ft. from S. Line

Ft. from E. Line

330

Ft. from W. Line

SW SW SW

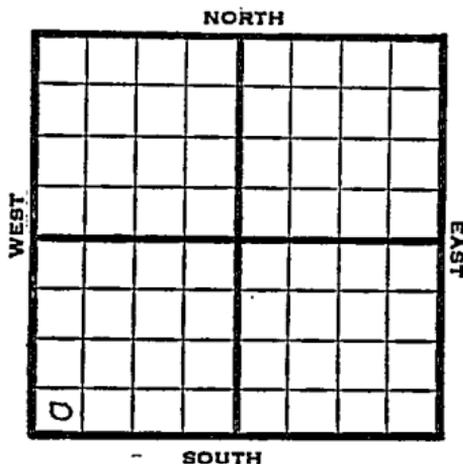

1952

Elev. 1437' REPORT

1/30

Spud 1-27-52  
10-3/4" @ 401' WOC

2/6

Drlg. 2590'

2/13

Miss 3123  
Drlg. 3345'

2/20

Spud 1-27-52  
D & A TD 3800'  
10-3/4" @ 401' Lans. 2462' Miss 3123  
Miss lime 3270', Kh. 3554', Maq.  
sh. 3562', Maq. dol. 3596',  
Viola 3630', Simp. 3685',  
DST 3698-3711, open 1 hr. rec 20'  
mud  
Arb. 3753' TD 3800' D & A

ABANDONED




County McPherson State Kansas

Sec. 17 (Blk. Twp.) 17 (Sur. Rge.) 4W Map No.

Operator Continental Oil

Well No. 1 Farm H. Anderson

Elev. 1437 Location SW SW SW

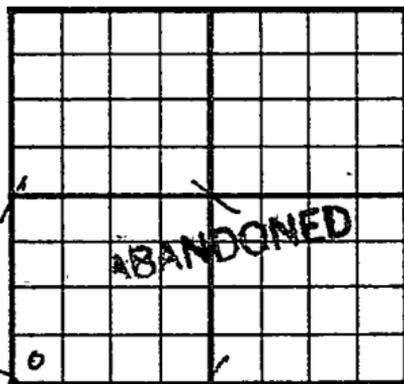

330 Ft. From S Line SW

330 Ft. From W Line Quarter

Ist. Report

Completion FEB 20 1952

Remarks Wildcat

Anschutz Drlg. - Contr.

Spudding Date 1-27-52

Drlg. Data D & A TD 3800

10 3/4" @ 401 Mans. 2462 Miss. 3124

Miss. lime 3270 Kh. 3554 Maq. sh. 3562

Maq. dol. 3596 Viola 3630 Simp. 3685

DST 3698-3711 open 1 hr. Rec. 20' mud

Arb. 3753 TD 3800

D & A

J. G. McGEHEE