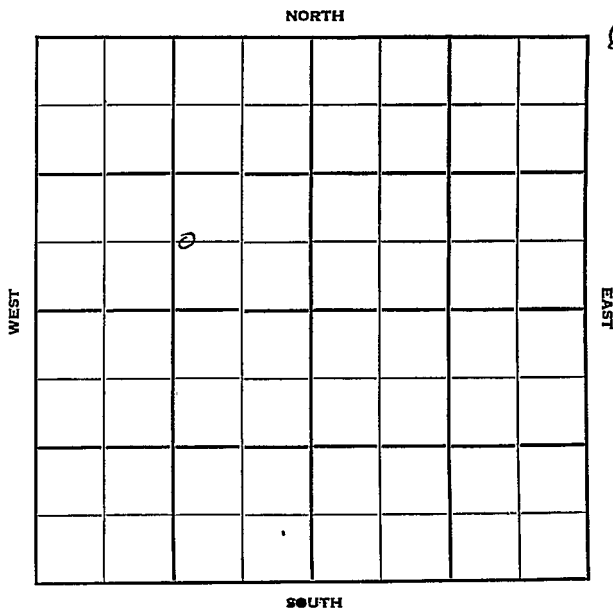


Section 17 Township 17 Range 3WWell No. #1-A Community "D"Company Bay Petroleum

McPherson

KANSAS

Sec. 17 Twp. 17 R. 3W ✓

Well No. #1-A Community "D" Farm

Bay Petroleum Company

Jackson-Lindsley - Contr. Contractor

Lindsborg Pool


         Ft. from N. Line

660' Ft. from S. Line


1200' Ft. from E. Line

         Ft. from W. Line

C W L S E N W

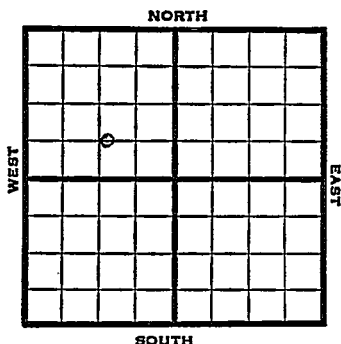

| 1951      | Elev. 1334'   | REPORT                                     |
|-----------|---|--------------------------------------------|
| 6/6       | Spud 5-29-51<br>13" @ 157<br>8" @ 345<br>Drlg. 2215'   |                                            |
| 9/12      | Spud 5-29-51<br>13" @ 157<br>DST 3329-48 open 1/2 hr. rec 5' mud<br>Viola 3375'<br>DST 3381-98' open 1 hr. rec 90' fluid<br>(40' was oil) Simp. sd. 3463'<br>TD 3467' 5" @ 3463' CO to 3467'<br>water. PB 3461' 33/3387-98<br>S/4 BOPH<br>Comp. 50 BOPD | Oil well TD 3467' .<br>8" @ 345 Maq. 3329' |
| COMPLETED |   |                                            |

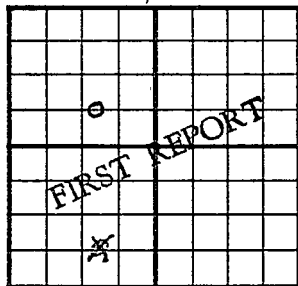County McPherson State KansasSec. 17 (Blk. Twp.) 17 (Sur. Rge.) 3W Map No.Operator Bay PetroleumWell No. 1-A Farm Community "D"Elev. 1334 Location C W L SE NW660 Ft. From S Line NW1200  
990 Ft. From E Line Quarter1st. Report JUN 6 1951

Completion

Remarks

Jackson - Lindsley - ContrSpudding Date 5-29-51Drlg. Data Lindsborg Pool13" @ 157 8" @ 345 drlg. 2215

check spot

Check spot think in NW Quarter


Advise

Sam

OK JUL 13 1951

|                |       |
|----------------|-------|
| Scout Cards    | ..... |
| Land Small Map | ..... |
| Land Wall Map  | ..... |
| Tracings       | ..... |
| France Map     | ..... |
| Pierce Map     | ..... |
| Misc.          | ..... |

County McPherson State Kansas  
 Sec. 17 (Blk. Twp.) 17 (Sur. Rge.) 3W Map No. \_\_\_\_\_  
 Operator Bay Petroleum  
 Well No. 1-A Farm Community "D"  
 Elev. 1334 Location C W L SE NW

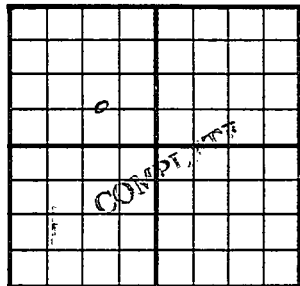

660 Ft. From S Line NW  
1200 Ft. From E Line Quarter  
 1st. Report \_\_\_\_\_  
 Completion SEP 12 1951  
 Remarks Lindsborg Pool  
Jackson-Lindsley - Contr.  
 Spudding Date 5-29-51

Drilg. Data Oil well TD 3467  
13" @ 157 8" @ 345 Maq. 3329  
DST 3329-48 open  $\frac{1}{2}$  hr. Rec. 5 $\frac{1}{2}$  mud  
Viola 3375 DST 338 $\frac{1}{2}$ -98 open 1 hr.  
Rec. 90' fluid (40' was oil) Simp. sd. 3463  
TD 3467 5" @ 3463 CO to 3467 water  
PB 3461 33/ 3387-98 S/ 4 boph  
Comp. 50 bopd

Scout Cards *mm*

Land Small Map

Land Wall Map *3*

Tracings

France Map

Pierce Map

Misc.

SEP 19 1951

Orig. Data